

# CERTIFICATE OF LOCATION OF GOVERNMENT CORNER

County of Anoka


State of Minnesota

CENTER Corner of Sec. 22 Township 32 Range 24

I hereby certify that on the 9 day of SEPT., 1960, I found the described corner which was evidenced by PINCHED I. P.

and I further certify that to perpetuate the location of said corner, I did, at the exact location thereof, place a permanent marker consisting of CAST IRON MON.

which reference or witness monuments are located in the manner following:

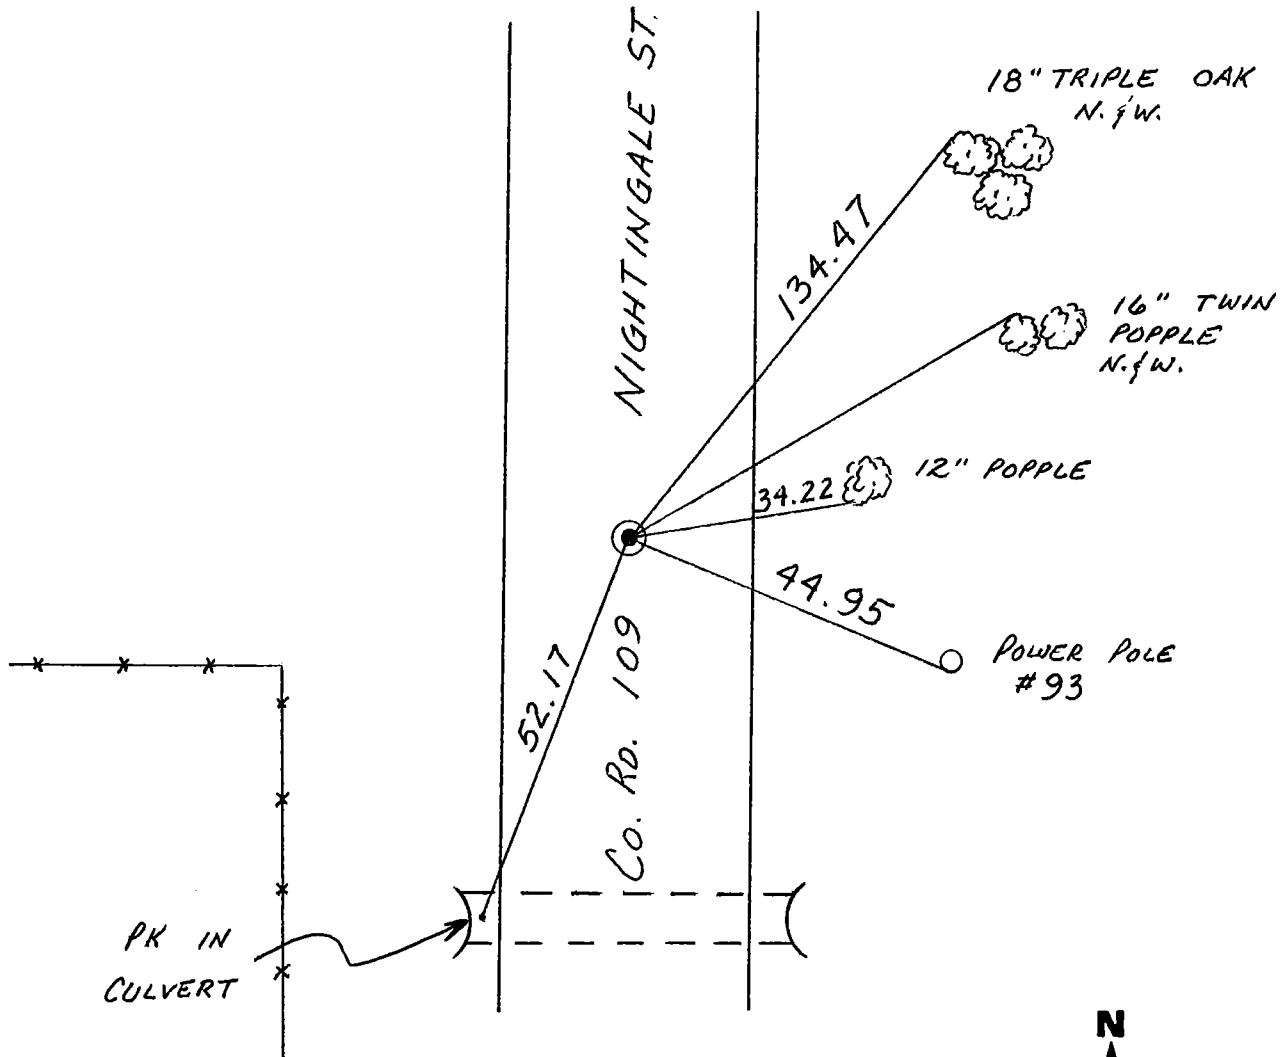

Revised date	Revised date	Revised date
6-25-82		
6-6-85		
7-29-88		

