

# CERTIFICATE OF LOCATION OF GOVERNMENT CORNER

County of Anoka

State of Minnesota



## Northwest Corner of Sec. 27 Township 32 Range 24

On the 8th day of August, 1960, the described corner was evidenced by a 1/2" iron pipe

and to perpetuate the location of said corner, at the exact location thereof, a permanent marker was placed consisting of a cast iron monument with a sign and post on the north side

AND on the 11th day of October, 2010, said permanent marker was found up 0.1'± and the ties were updated

Updated reference ties are as shown below.

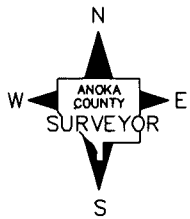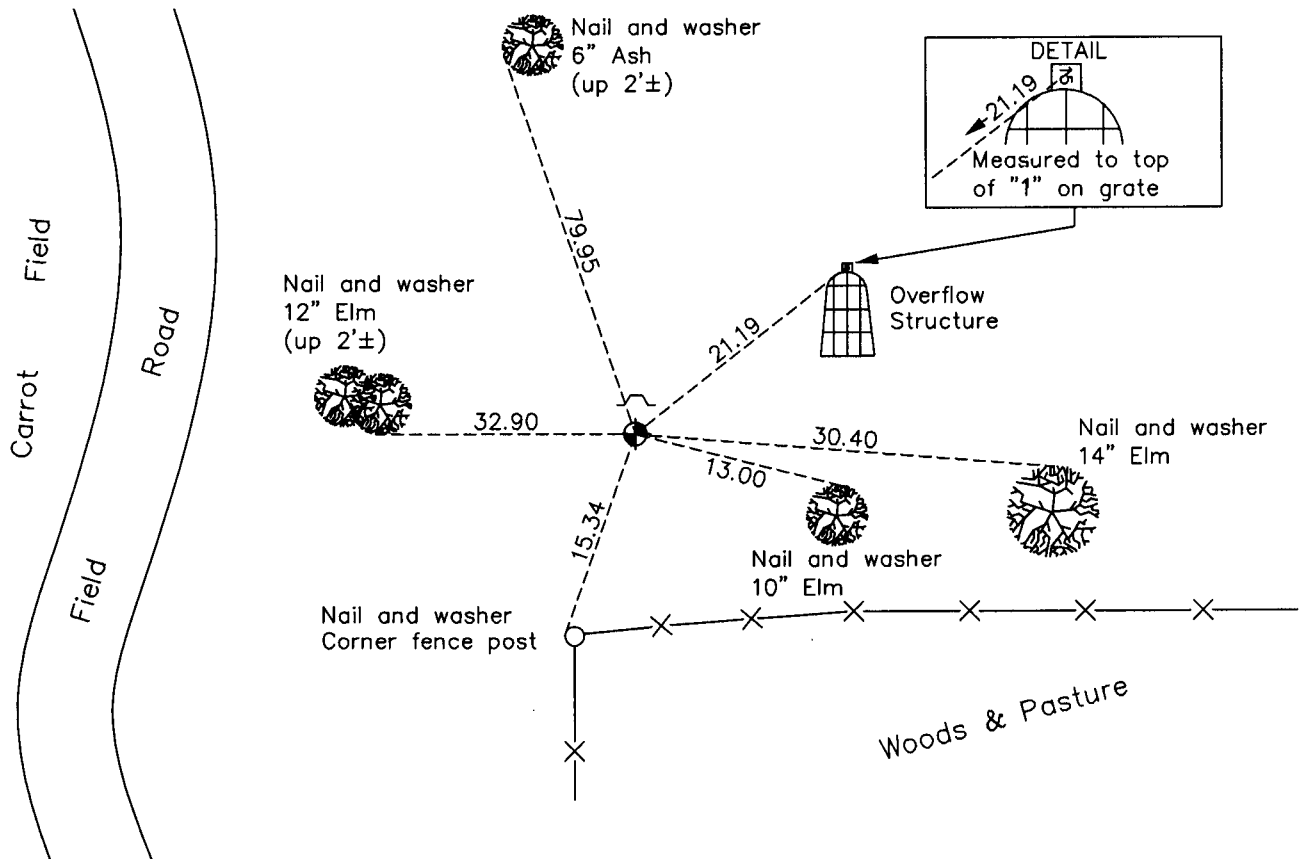

Revision Date  
5/23/11

N.A.D. 1983 Coordinates  
(1996 Adjustment)

| County Project Coordinates |                    |
|----------------------------|--------------------|
| Northing                   | <u>175109.7693</u> |
| Easting                    | <u>484602.8766</u> |
| Date                       | <u>7/31/00</u>     |

I hereby certify that this United States public land survey monument record is correct and complete to the best of my knowledge and belief.

*Larry D. Hoium* Date 5/23/11

Larry D. Hoium, Anoka County Surveyor

Minnesota License Number 18165