

CERTIFICATE OF LOCATION OF GOVERNMENT CORNER

County of Anoka

State of Minnesota



Meander #9 Corner of Sec. 20 Township 32 Range 24

On the 2nd day of July, 1963, the described corner was evidenced by area resurvey

and to perpetuate the location of said corner, at the exact location thereof, a permanent marker was placed consisting of a cast iron monument sitting on top of a large tree root, with a sign and post on the north side

AND on the 29th day of October, 2010, said permanent marker was found up 0.2'± and the ties were updated

Updated reference ties are as shown below.

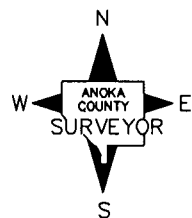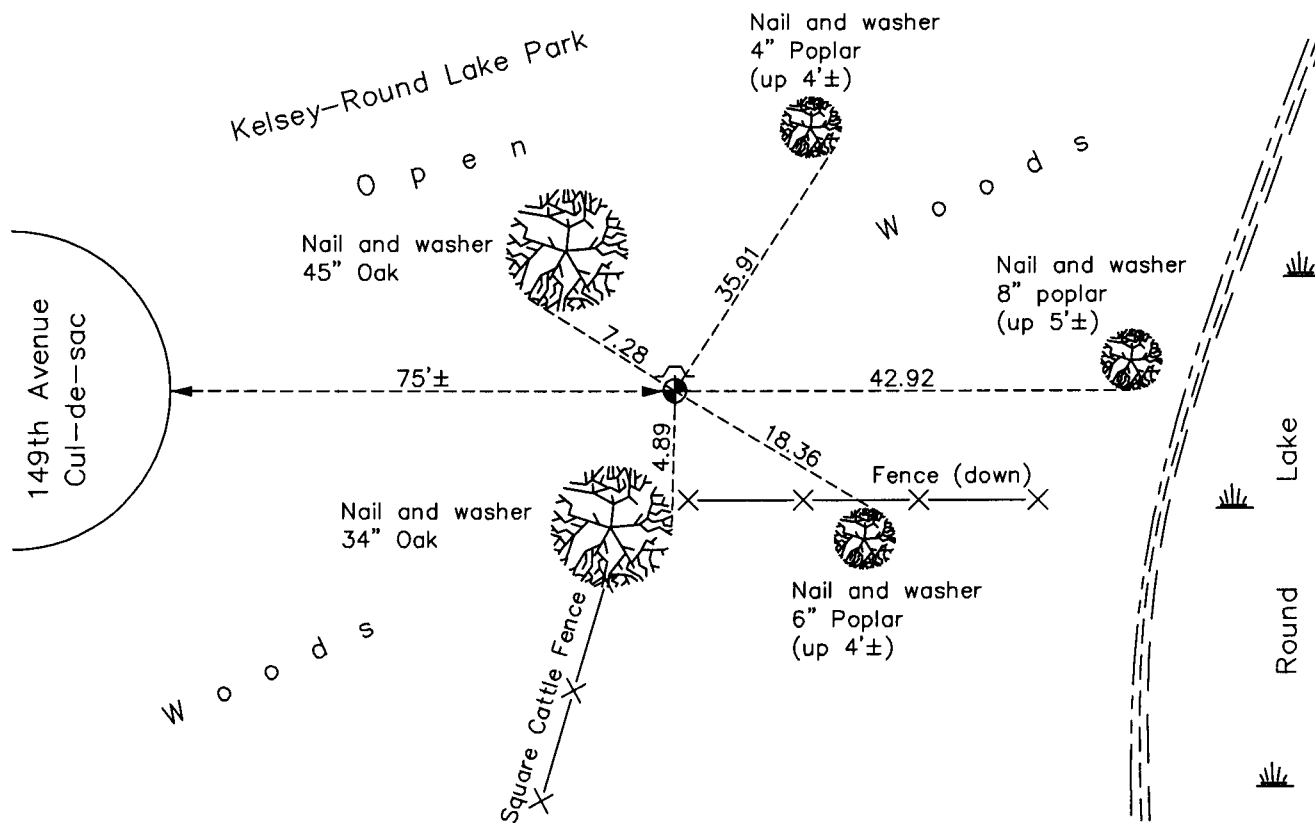

Revision Date

5/24/11

N.A.D. 1983 Coordinates
(1996 Adjustment)

County Project Coordinates	
Northing	175113.9489
Easting	474707.2432
Date	1/02/01

I hereby certify that this United States public land survey monument record is correct and complete to the best of my knowledge and belief.

Larry D. Hoium Date 5/24/11

Larry D. Hoium, Anoka County Surveyor

Minnesota License Number 18165