

CERTIFICATE OF LOCATION OF GOVERNMENT CORNER

County of Anoka

State of Minnesota

Witness Corner of Sec. 19 Township 32 Range 24



(On south line of SW 1/4 - 2104' West of S 1/4 corner)

On the 10th day of July, 1963, the described corner was evidenced by area resurvey

and to perpetuate the location of said corner, at the exact location thereof, a permanent marker was placed consisting of a cast iron monument with a sign and post on the north side

AND on the 1st day of November, 2010, said permanent marker was found down 0.1'± and the ties were updated

Updated reference ties are as shown below.

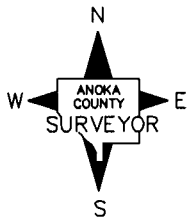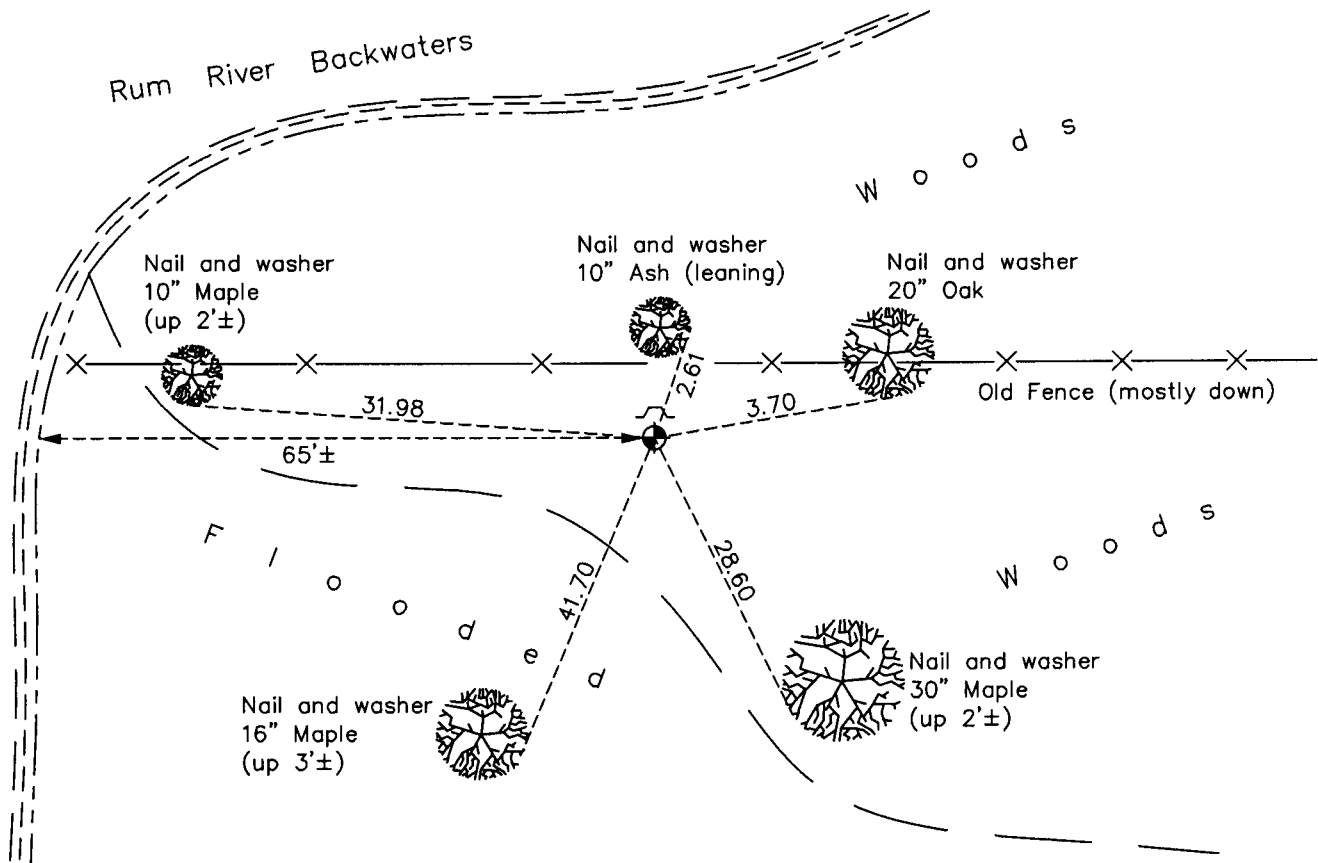

Revision Date
5/24/11

N.A.D. 1983 Coordinates
 (1996 Adjustment)

County Project Coordinates	
Northing	175103.1383
Easting	469309.1672
Date	5/07/02

I hereby certify that this United States public land survey monument record is correct and complete to the best of my knowledge and belief.

Larry D. Hoium Date 5/24/11

 Larry D. Hoium, Anoka County Surveyor

Minnesota License Number 18165