CERTIFICATE OF LOCATION OF GOVERNMENT CORNER

County of Anoka

State of Minnesota


Witness Corner of Sec. 29 Township 32 Range 24
(Witness corners to W 1/4 Sec. 29)

On the 22nd day of September, 1992, the described corner was evidenced by area resurvey

and to perpetuate the location of said corner, at the exact location thereof, a permanent marker was placed consisting of cast iron monuments at both witness corners

AND on the 14th day of <u>January</u>, 2011, said permanent marker was <u>found</u> and the ties were updated

Updated reference ties are as shown below.

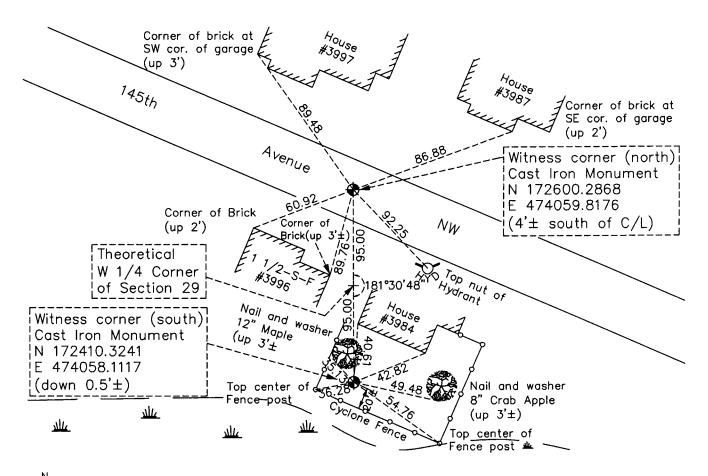



5/25/11

N.A.D. 1983 Coordinates (1996 Adjustment)

County Project Coordinates	
Northing <u>See above</u>	
Easting	
Date	

I hereby certify that this United States public land survey monument record is correct and complete to the best of my knowledge and bejief.

Larry D. Hoium , Anoka County Surveyor Minnesota License Number _______18165