

CERTIFICATE OF LOCATION OF GOVERNMENT CORNER

County of Anoka

State of Minnesota



Witness Corner of Sec. 32 Township 32 Range 24
 (on north line of NE 1/4)

On the 10th day of July, 1990, the described corner was evidenced by area resurvey

and to perpetuate the location of said corner, at the exact location thereof, a permanent marker was placed consisting of a cast iron monument with a sign and post on the north side

AND on the 4th day of November, 2010, said permanent marker was found down 0.3'± and the ties were updated

Updated reference ties are as shown below.

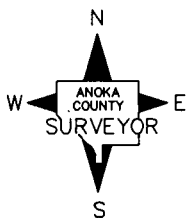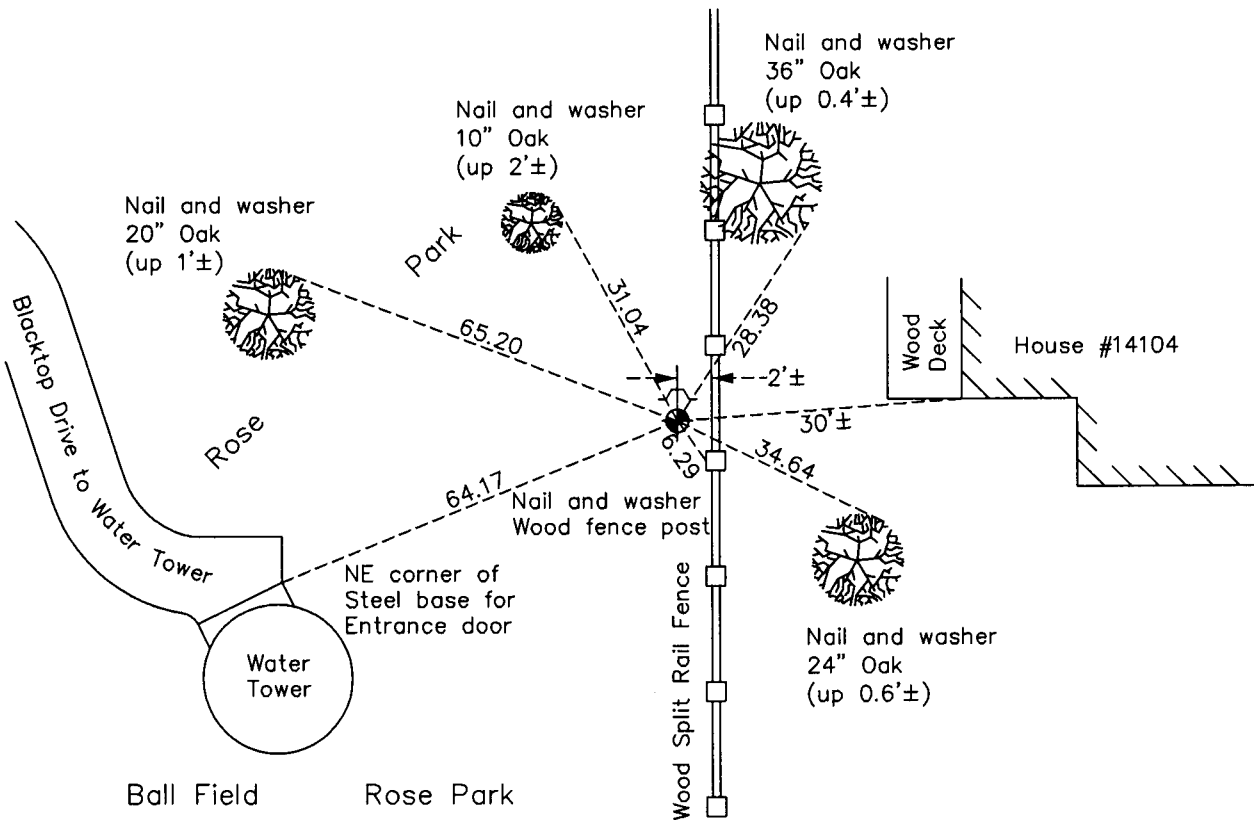

Revision Date

6/21/11

N.A.D. 1983 Coordinates
 (1996 Adjustment)

County Project Coordinates	
Northing	169823.0821
Easting	477947.0125
Date	10/26/00

I hereby certify that this United States public land survey monument record is correct and complete to the best of my knowledge and belief.

Larry D. Hoium Date 6/21/11

Larry D. Hoium, Anoka County Surveyor

Minnesota License Number 18165