

CERTIFICATE OF LOCATION OF GOVERNMENT CORNER

County of Anoka

State of Minnesota



North 1/4 Corner of Sec. 31 Township 32 Range 24

On the 14th day of September, 1964, the described corner was evidenced by a 1/2" iron pipe

and to perpetuate the location of said corner, at the exact location thereof, a permanent marker was placed consisting of a cast iron monument

AND on the 14th day of January, 2011, said permanent marker was found and the ties were updated

Updated reference ties are as shown below.

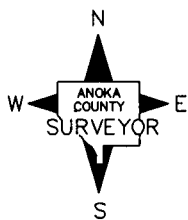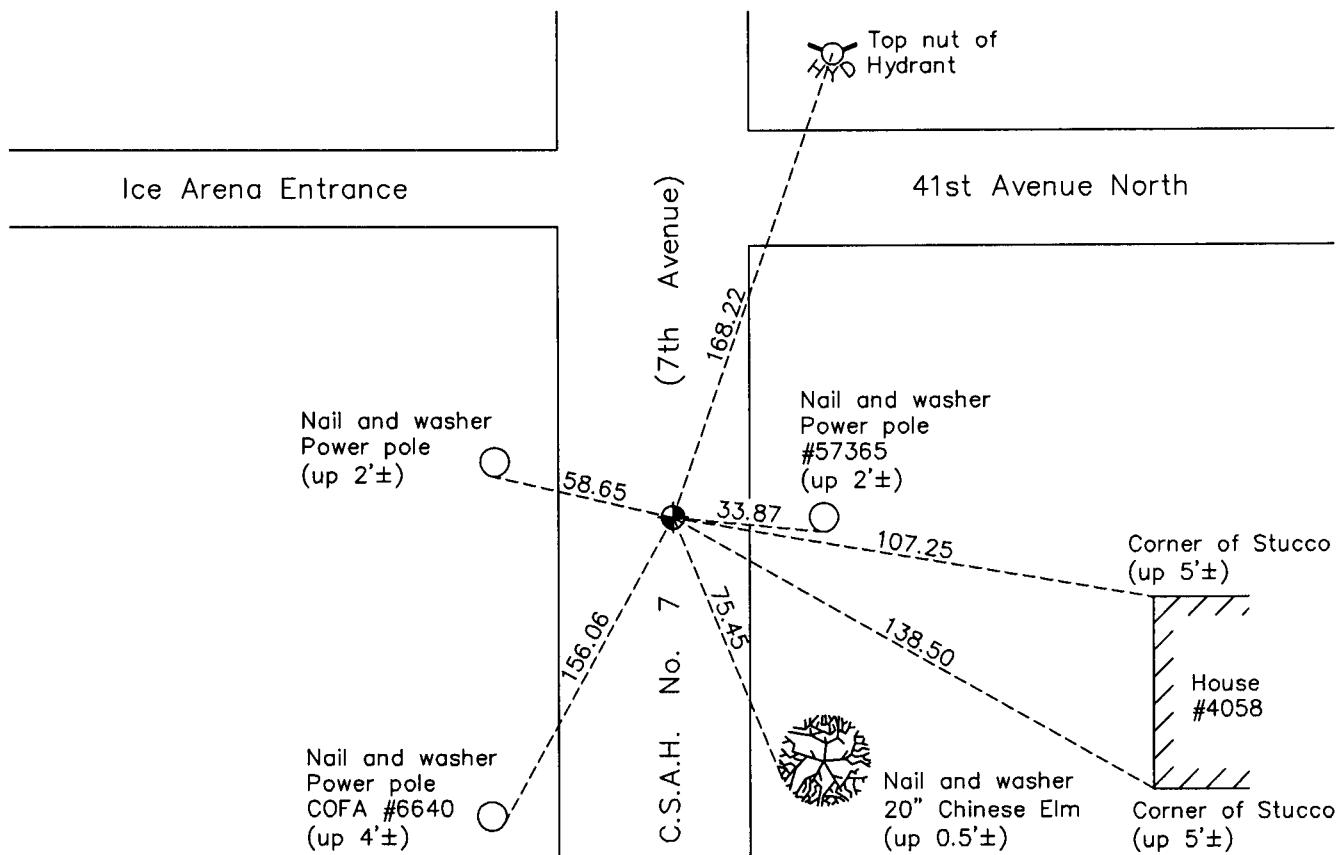

Revision Date
6/21/11

N.A.D. 1983 Coordinates
(1996 Adjustment)

County Project Coordinates	
Northing	<u>169848.0449</u>
Easting	<u>471365.5489</u>
Date	<u>11/27/00</u>

I hereby certify that this United States public land survey monument record is correct and complete to the best of my knowledge and belief.

Larry D. Hoium Date 6/21/11

Larry D. Hoium, Anoka County Surveyor

Minnesota License Number 18165