

CERTIFICATE OF LOCATION OF GOVERNMENT CORNER


County of Anoka State of Minnesota

Center Corner of Sec. 35 Township 32 Range 24


I hereby certify that on the 12th day of October, 1977, I found the described corner which was evidenced by area resurvey

and I further certify that to perpetuate the location of said corner, I did, at the exact location thereof, place a permanent marker consisting of a cast iron monument

which reference or witness monuments are located in the manner following:

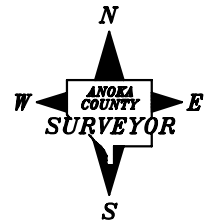

COUNTY ROAD NO. 116 (BUNKER LAKE BLVD.)

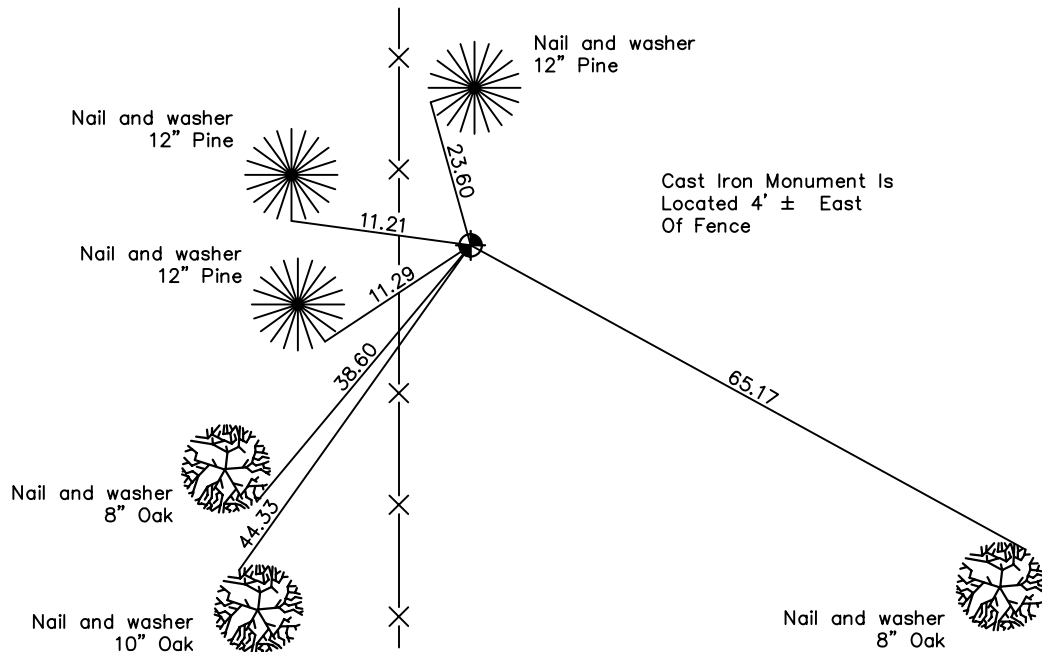

Revised date

6/29/82
5/28/85
8/4/88

N.A.D. 1983 Co-ordinates

County Project Co-ordinates	State Plane Co-ordinates
Northing _____	Y _____
Easting _____	X _____

Date(No GPS Info Taken)