

CERTIFICATE OF LOCATION OF GOVERNMENT CORNER

County of Anoka

State of Minnesota

Witness Corner of Sec. 35 Township 32 Range 24



(on east line of section)

On the 16th day of March, 1967, the described corner was evidenced by area resurvey

and to perpetuate the location of said corner, at the exact location thereof, a permanent marker was placed consisting of a cast iron monument

AND on the 2nd day of November, 2010, said permanent marker was found flush with the surface and the ties were updated

Updated reference ties are as shown below.

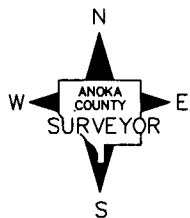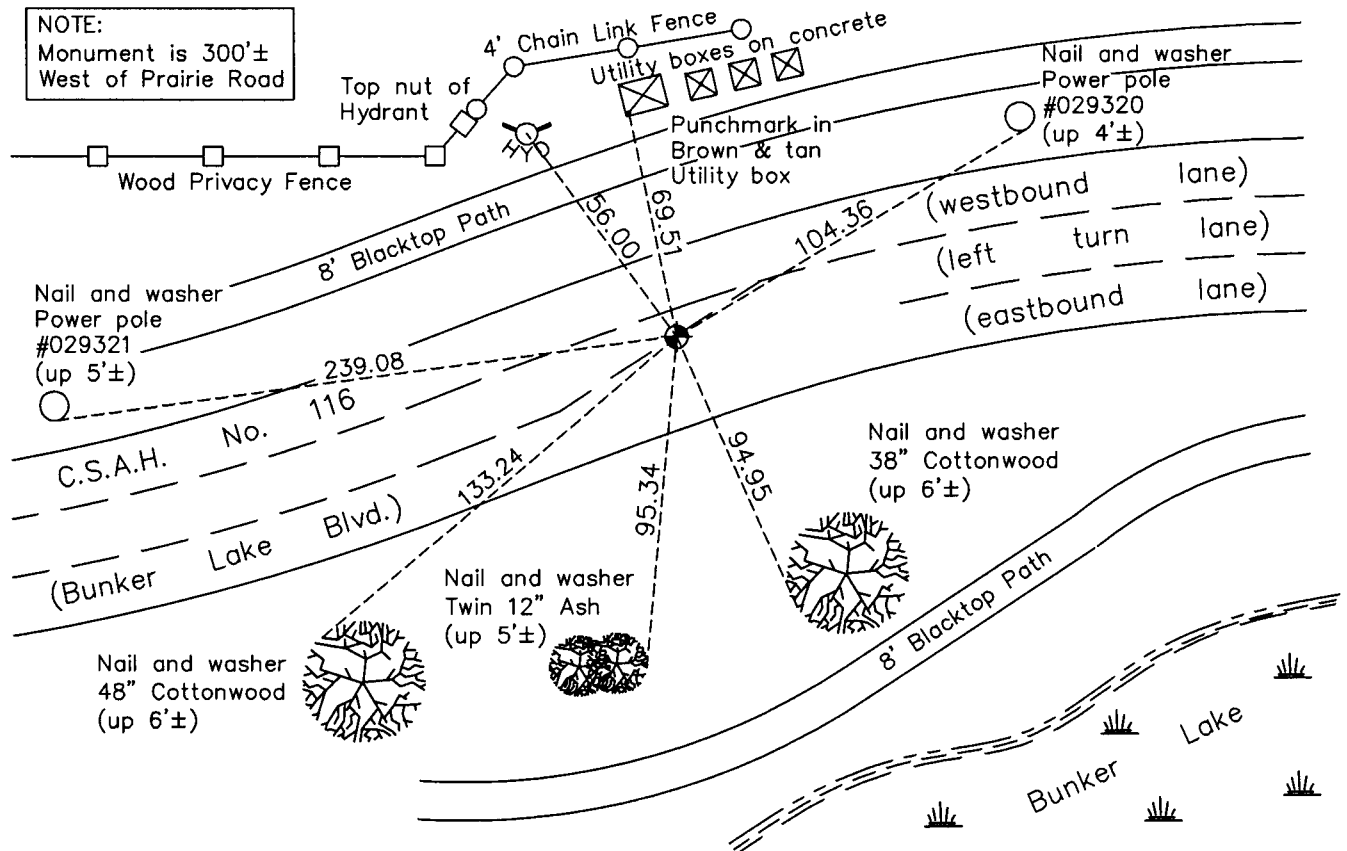

N.A.D. 1983 Coordinates (1996 Adjustment)

County Project Coordinates

Northing 167569.0000

Easting 495040.9844

Date 10/24/00

I hereby certify that this United States public land survey monument record is correct and complete to the best of my knowledge and belief.

Larry D. Hoium Date 6/24/11

Larry D. Hoium, Anoka County Surveyor

Minnesota License Number 18165

Revision Date

6/24/11