

CERTIFICATE OF LOCATION OF GOVERNMENT CORNER

County of Anoka

State of Minnesota


Center Corner of Sec. 36 Township 32 Range 24

Of The Southeast Quarter

I hereby certify that on the 5th day of October, 1973, I found the described corner which was evidenced by area resurvey

and I further certify that to perpetuate the location of said corner, I did, at the exact location thereof, place a permanent marker consisting of a cast iron monument with sign and post on the north side

which reference or witness monuments are located in the manner following:

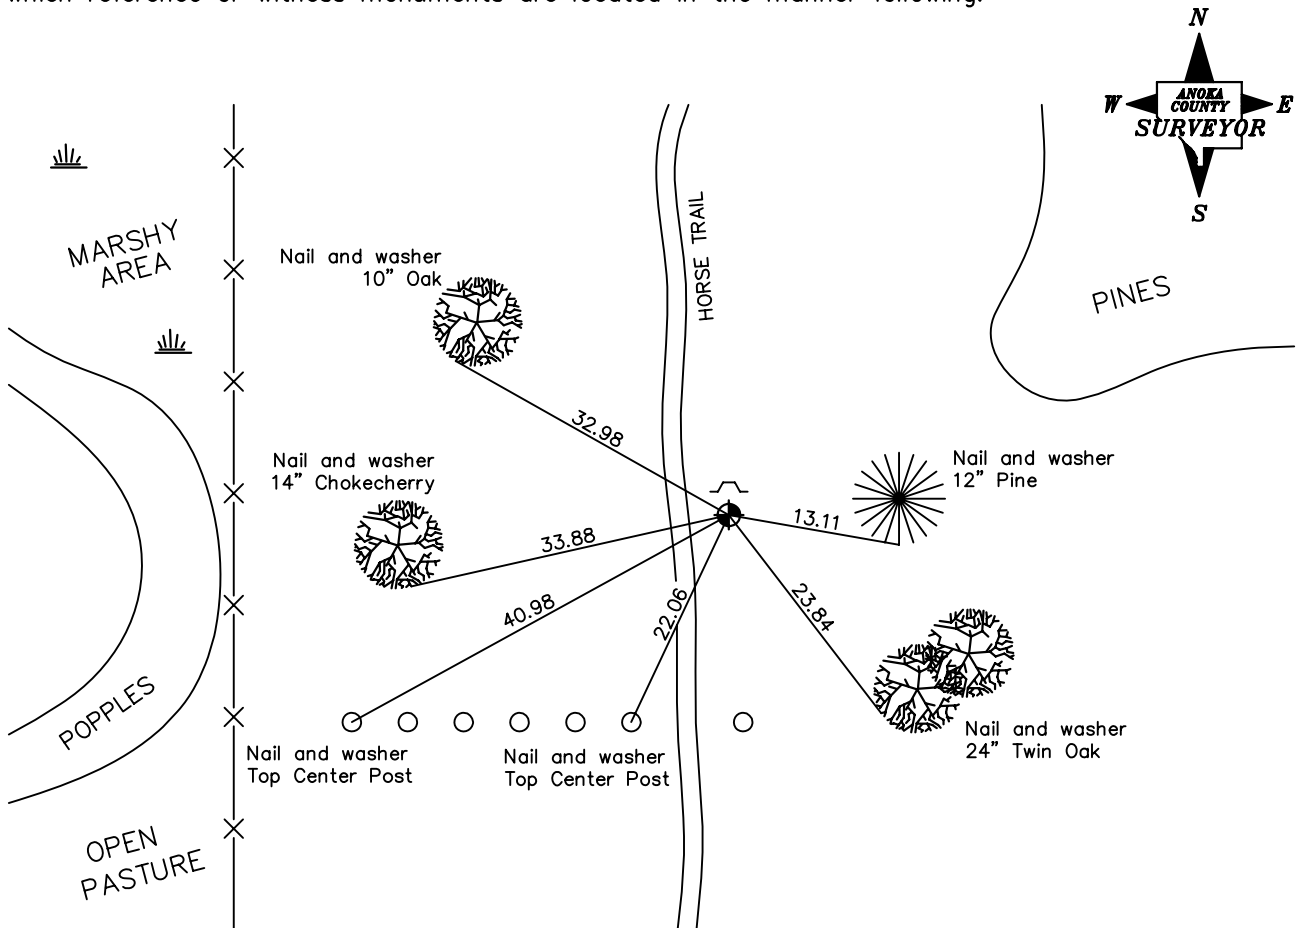

Revised date

| |
|---------|
| 7/7/82 |
| 5/28/85 |
| 8/5/88 |
| |
| |

N.A.D. 1983 Co-ordinates

| County Project Co-ordinates | State Plane Co-ordinates |
|-----------------------------|--------------------------|
| Northing _____ | Y _____ |
| Easting _____ | X _____ |

Date(No GPS Info Taken)