

CERTIFICATE OF LOCATION OF GOVERNMENT CORNER

County of Anoka

State of Minnesota



East 1/4 Corner of Sec. 25 Township 32 Range 24

On the 14th day of September, 1960, the described corner was evidenced by a concrete monument

and to perpetuate the location of said corner, at the exact location thereof, a permanent marker was placed consisting of a cast iron monument

AND on the 22nd day of October, 2010, said permanent marker was found flush with the surface and the ties were updated

Updated reference ties are as shown below.

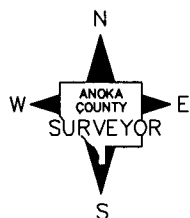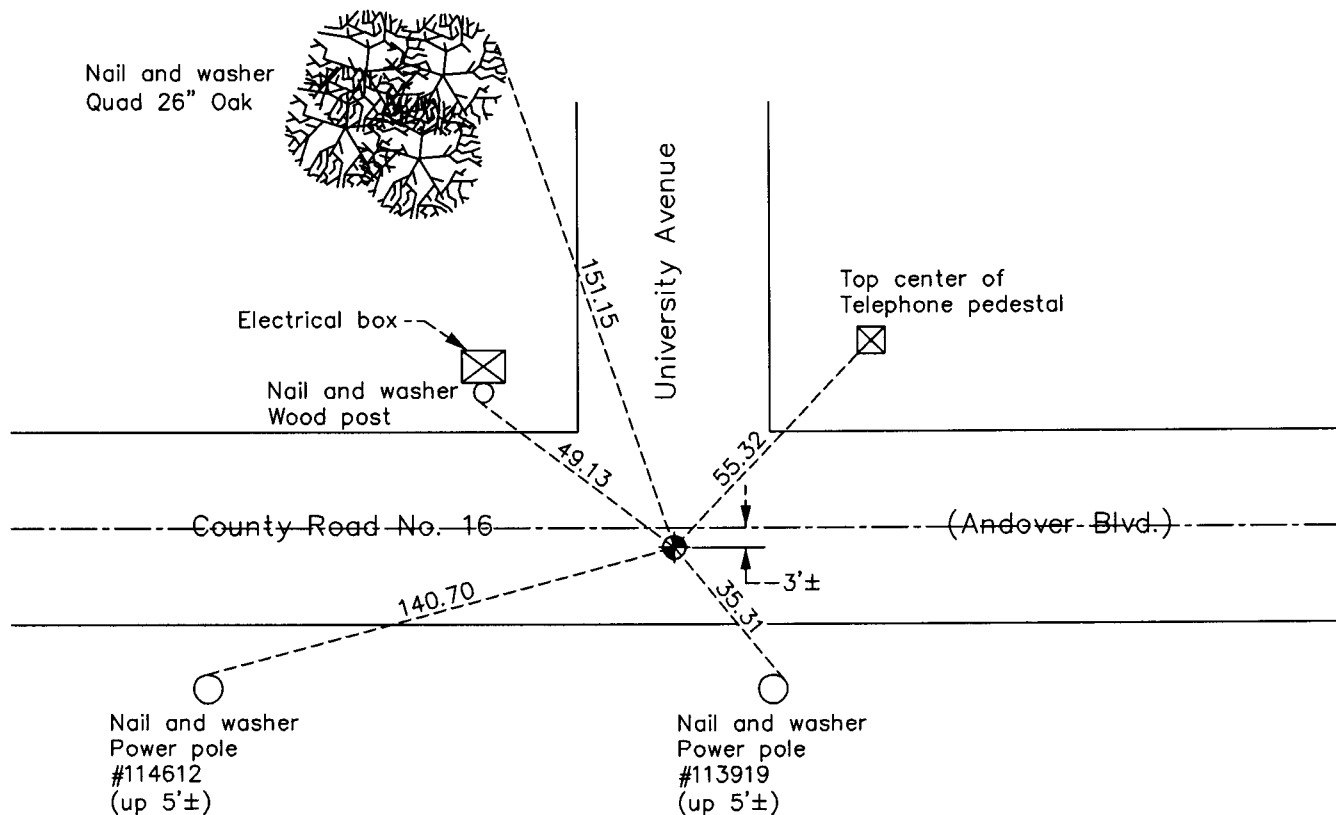

Revision Date

6/28/11

N.A.D. 1983 Coordinates
(1996 Adjustment)

County Project Coordinates	
Northing	172197.3230
Easting	500288.9357
Date	10/24/00

I hereby certify that this United States public land survey monument record is correct and complete to the best of my knowledge and belief.

Larry D. Hoium Date 6/28/11

Larry D. Hoium, Anoka County Surveyor

Minnesota License Number 18165