

# CERTIFICATE OF LOCATION OF GOVERNMENT CORNER

County of Anoka

State of Minnesota



## North $\frac{1}{4}$ Corner of Sec. 1 Township 32 Range 23

On the 28th day of December, 1962, the described corner was evidenced by an iron pipe

and to perpetuate the location of said corner, at the exact location thereof, a permanent marker was placed consisting of a cast iron monument

AND on the 1st day of April, 2011, said permanent marker was found and the ties were updated. A sign and post was set on the north side.

Updated reference ties are as shown below.

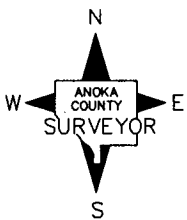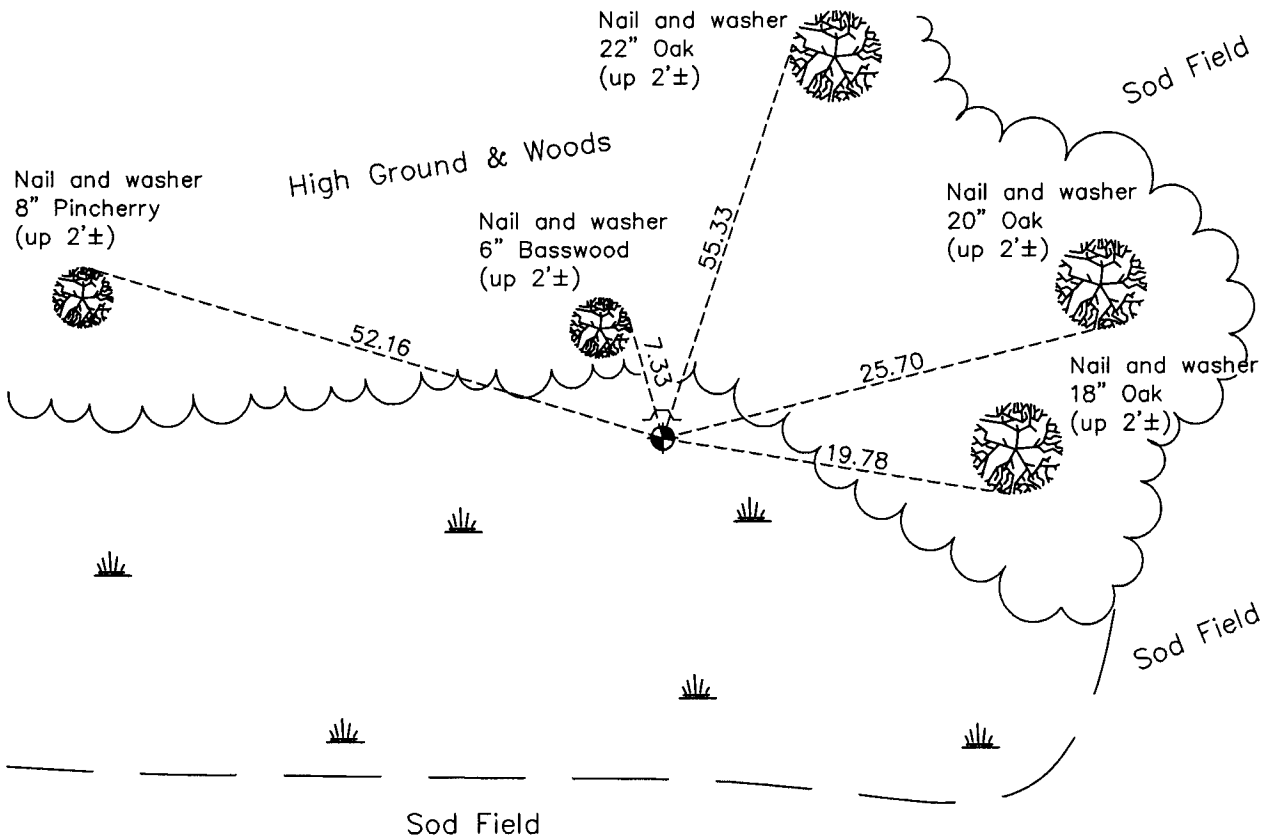

Revision Date  
8/10/11

N.A.D. 1983 Coordinates  
(1996 Adjustment)

County Project Coordinates	
Northing	195598.9100
Easting	529324.0289
Date	9/05/96

I hereby certify that this United States public land survey monument record is correct and complete to the best of my knowledge and belief.

Larry D. Hoium Date 8/10/11  
 Larry D. Hoium, Anoka County Surveyor  
 Minnesota License Number 18165