

CERTIFICATE OF LOCATION OF GOVERNMENT CORNER

County of Anoka

State of Minnesota



Meander Corner of Sec. 3 Township 32 Range 23 (on west side of Coon Lake)

On the 20th day of December, 1960, the described corner was evidenced by a concrete monument

and to perpetuate the location of said corner, at the exact location thereof, a permanent marker was placed consisting of the same concrete monument

AND on the 17th day of March, 2011, said permanent marker was found leaning slightly to the west and up 0.5'± with a 'T' post on the west side. The ties were updated

Updated reference ties are as shown below.

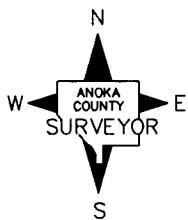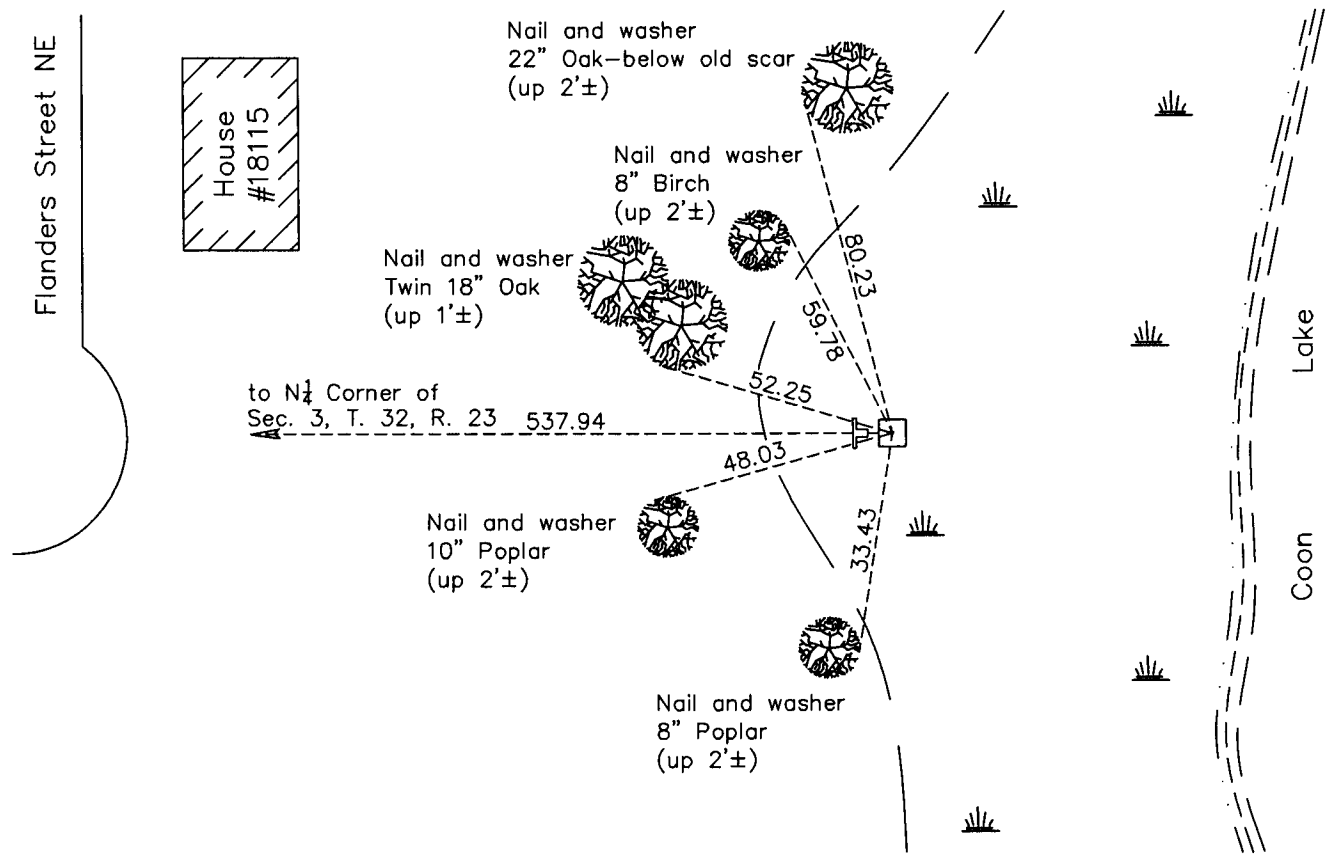

N.A.D. 1983 Coordinates
(1996 Adjustment)

County Project Coordinates	
Northing	195684.8774
Easting	519400.1926
Date	1/30/02

Revision Date
8/10/11

I hereby certify that this United States public land survey monument record is correct and complete to the best of my knowledge and belief.

Larry D. Hoium Date 8/10/11

Larry D. Hoium, Anoka County Surveyor

Minnesota License Number 18165