CERTIFICATE OF LOCATION OF GOVERNMENT CORNER

County of Anoka State of Minnesota

North 1/4 Corner of Sec. 3 Township 32 Range 23

I hereby certify that on the 22nd day of December, 1960, I found the described corner which was evidenced by a concrete monument

and I further certify that to perpetuate the location of said corner, I did, at the exact location thereof, place a permanent marker consisting of a concrete monument with sign and post on the north side

which reference or witness monuments are located in the manner following:

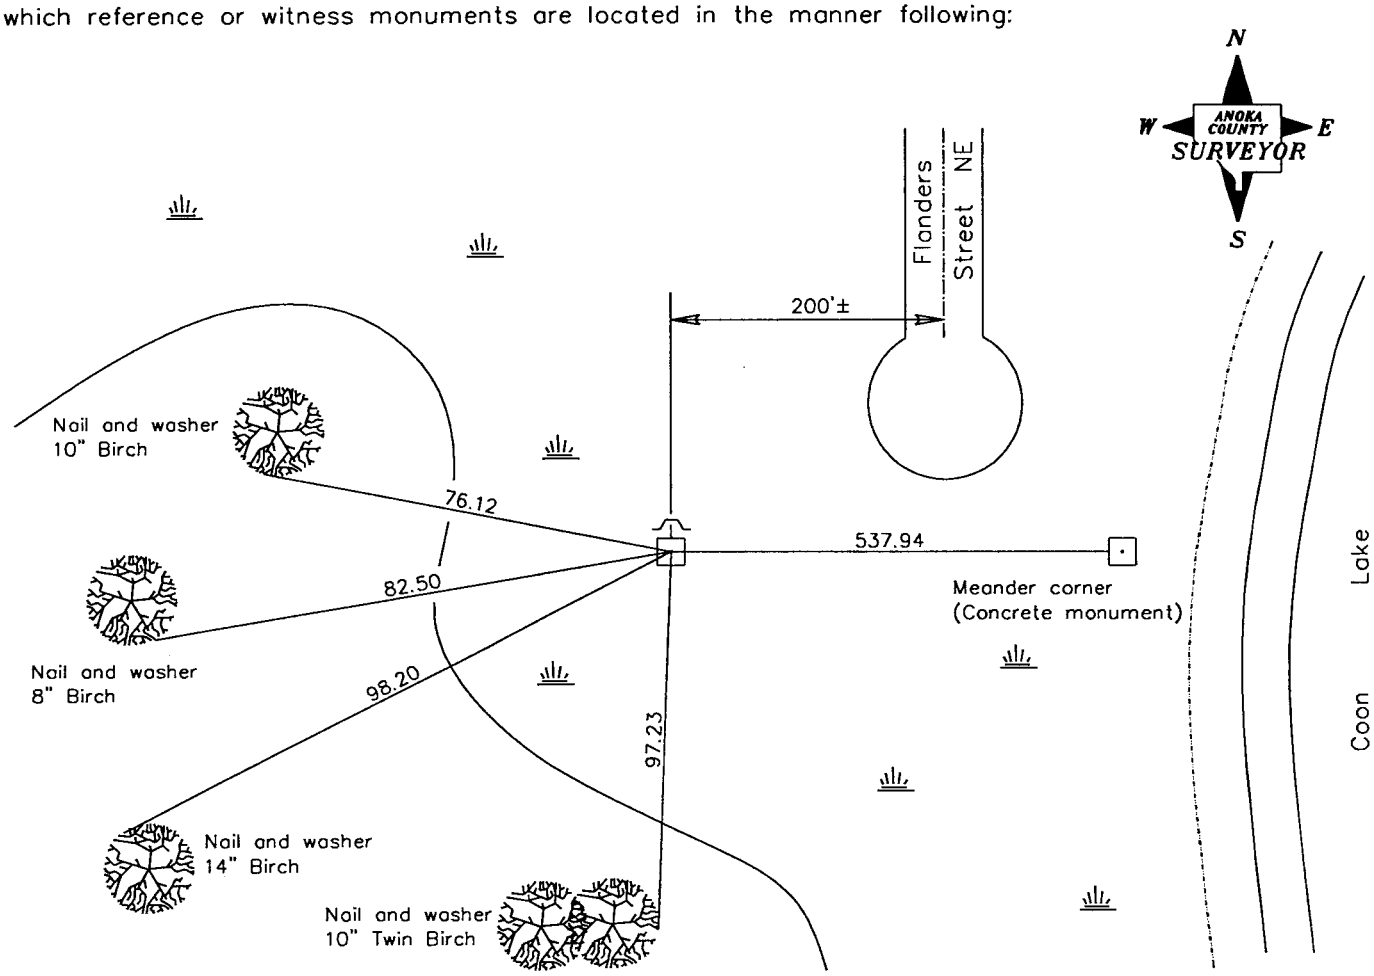

Revised date

Wet 1987
2/21/02

N.A.D. 1983 Coordinates
(1996 adjustment)

County Project Coordinates	State Plane Coordinates
Northing 195689.9500	Y
Easting 518862.6753	X

Date 2/21/02