

CERTIFICATE OF LOCATION OF GOVERNMENT CORNER

County of Anoka

State of Minnesota



West 1/4 Corner of Sec. 5 Township 32 Range 23

On the 20th day of July, 1964, the described corner was evidenced by a granite monument

and to perpetuate the location of said corner, at the exact location thereof, a permanent marker was placed consisting of a cast iron monument

AND on the 18th day of April, 2011, said permanent marker was found broken and was replaced with a new cast iron monument with sign & post set on south side and ties were updated.

Updated reference ties are as shown below.

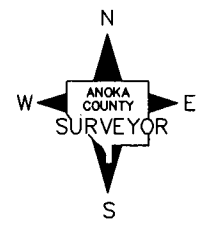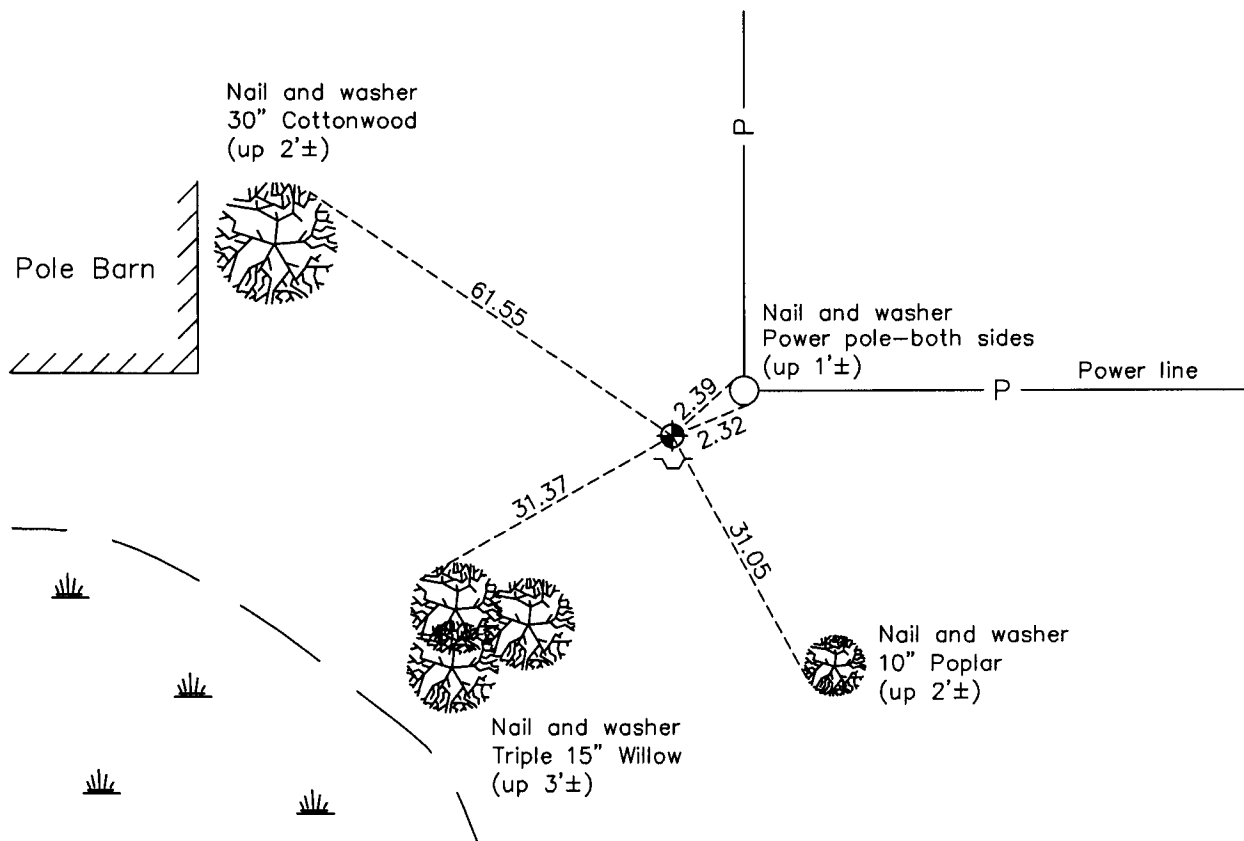

Revision Date
8/25/11

N.A.D. 1983 Coordinates
(1996 Adjustment)

County Project Coordinates	
Northing	<u>193444.4617</u>
Easting	<u>505603.2928</u>
Date	<u>8/15/96</u>

I hereby certify that this United States public land survey monument record is correct and complete to the best of my knowledge and belief.

Larry D. Hoium Date 8/25/11

Larry D. Hoium, Anoka County Surveyor
Minnesota License Number 18165