

CERTIFICATE OF LOCATION OF GOVERNMENT CORNER

County of Anoka

State of Minnesota


Witness Corner of Sec. 3 Township 32 Range 23
(on East-West 1/4 line)

On the 8th day of July, 1964, the described corner was evidenced by a concrete
monument

and to perpetuate the location of said corner, at the exact location thereof, a permanent marker was placed consisting of the same concrete monument

AND on the 6th day of April, 2011, said permanent marker was found up 0.5'± and
the ties were updated. A P.K. nail was set in the top of the concrete monument.

Updated reference ties are as shown below.

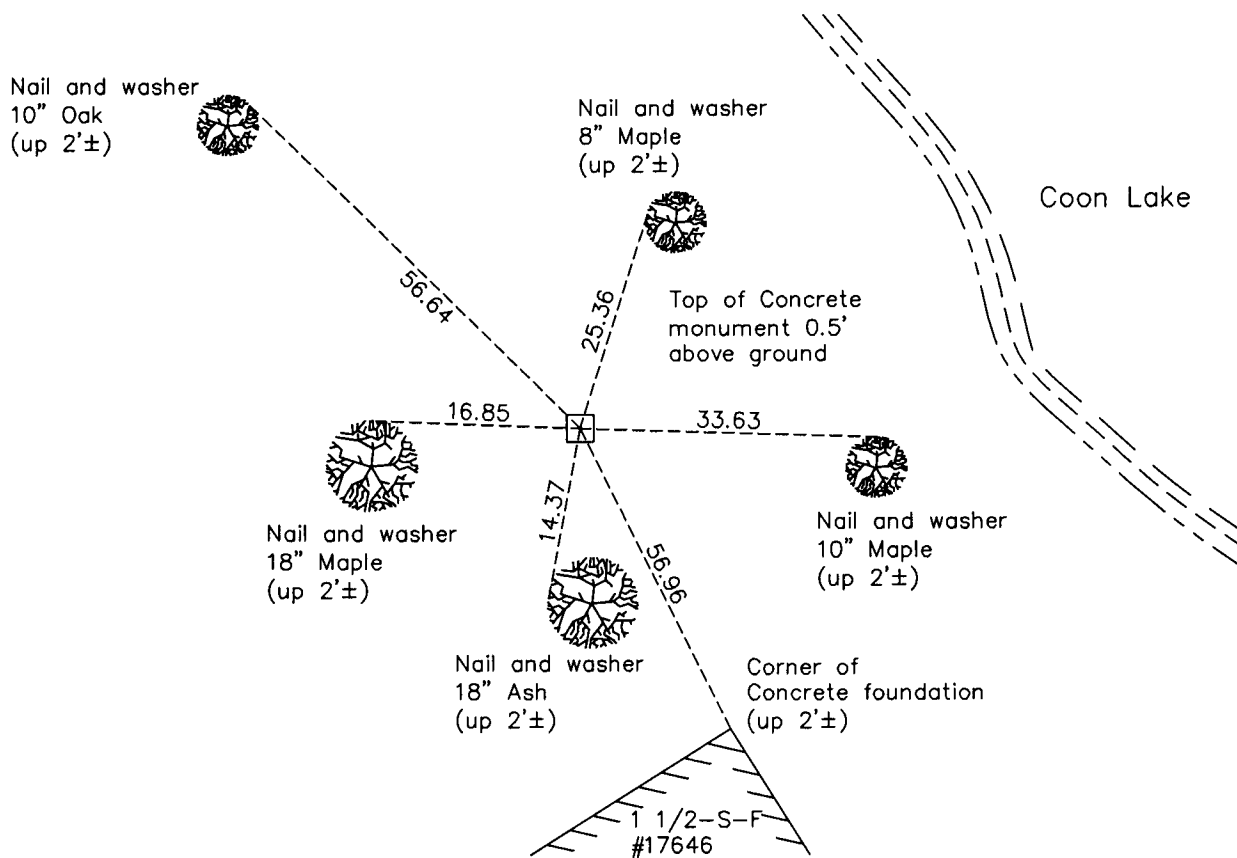

N
W ANOKA COUNTY SURVEYOR E
S

Revision Date
8/30/11

N.A.D. 1983 Coordinates
(1996 Adjustment)

County Project Coordinates	
Northing	193234.6862
Easting	520284.4220
Date	3/05/02

I hereby certify that this United States public land survey monument record is correct and complete to the best of my knowledge and belief.

Larry D. Hoium Date 8/30/11

Larry D. Hoium, Anoka County Surveyor
Minnesota License Number 18165