

CERTIFICATE OF LOCATION OF GOVERNMENT CORNER


County of Anoka State of Minnesota

West 1/4 Corner of Sec. 1 Township 32 Range 23

I hereby certify that on the 31st day of October, 1966, I found the described corner which was evidenced by area resurvey

and I further certify that to perpetuate the location of said corner, I did, at the exact location thereof, place a permanent marker consisting of a cast iron monument with sign and post on the north side

which reference or witness monuments are located in the manner following:

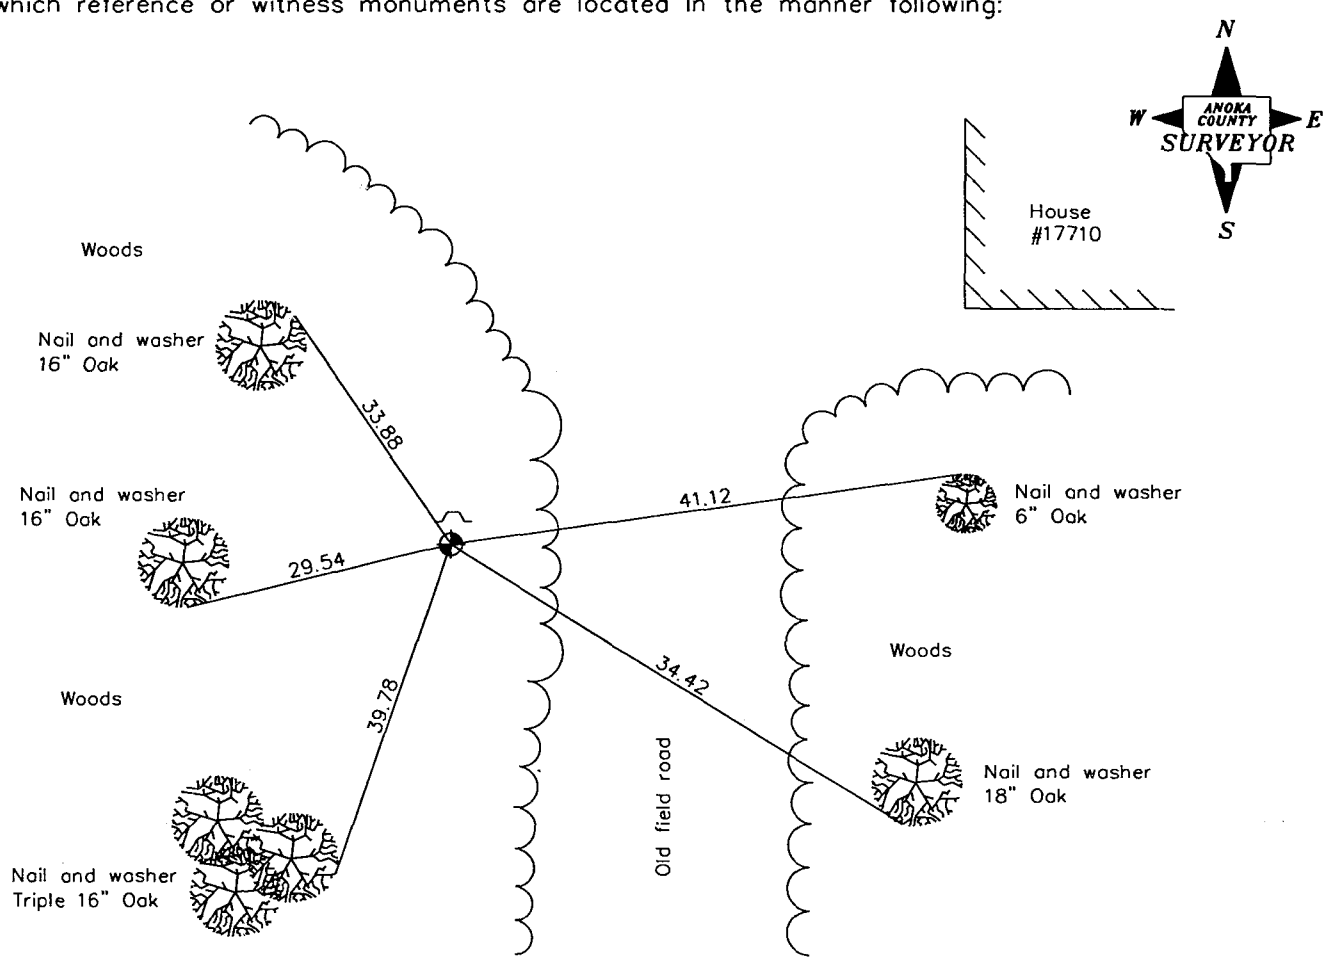

Revised date

8/09/83
7/06/87
11/15/91
8/14/96

N.A.D. 1983 Coordinates
(1996 adjustment)

County Project Coordinates	State Plane Coordinates
Northing <u>193460.6945</u>	Y _____
Easting <u>526806.6731</u>	X _____

Date 8/14/96