

CERTIFICATE OF LOCATION OF GOVERNMENT CORNER

County of Anoka

State of Minnesota



Southeast Corner of Sec. 1 Township 32 Range 23

On the 21st day of June, 1961, the described corner was evidenced by a concrete monument

and to perpetuate the location of said corner, at the exact location thereof, a permanent marker was placed consisting of a cast iron monument with "State Wildlife Management" signs on the north and northwest sides

AND on the 4th day of April, 2011, said permanent marker was found and the ties were updated

Updated reference ties are as shown below.

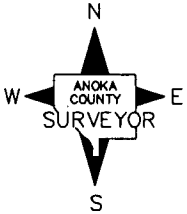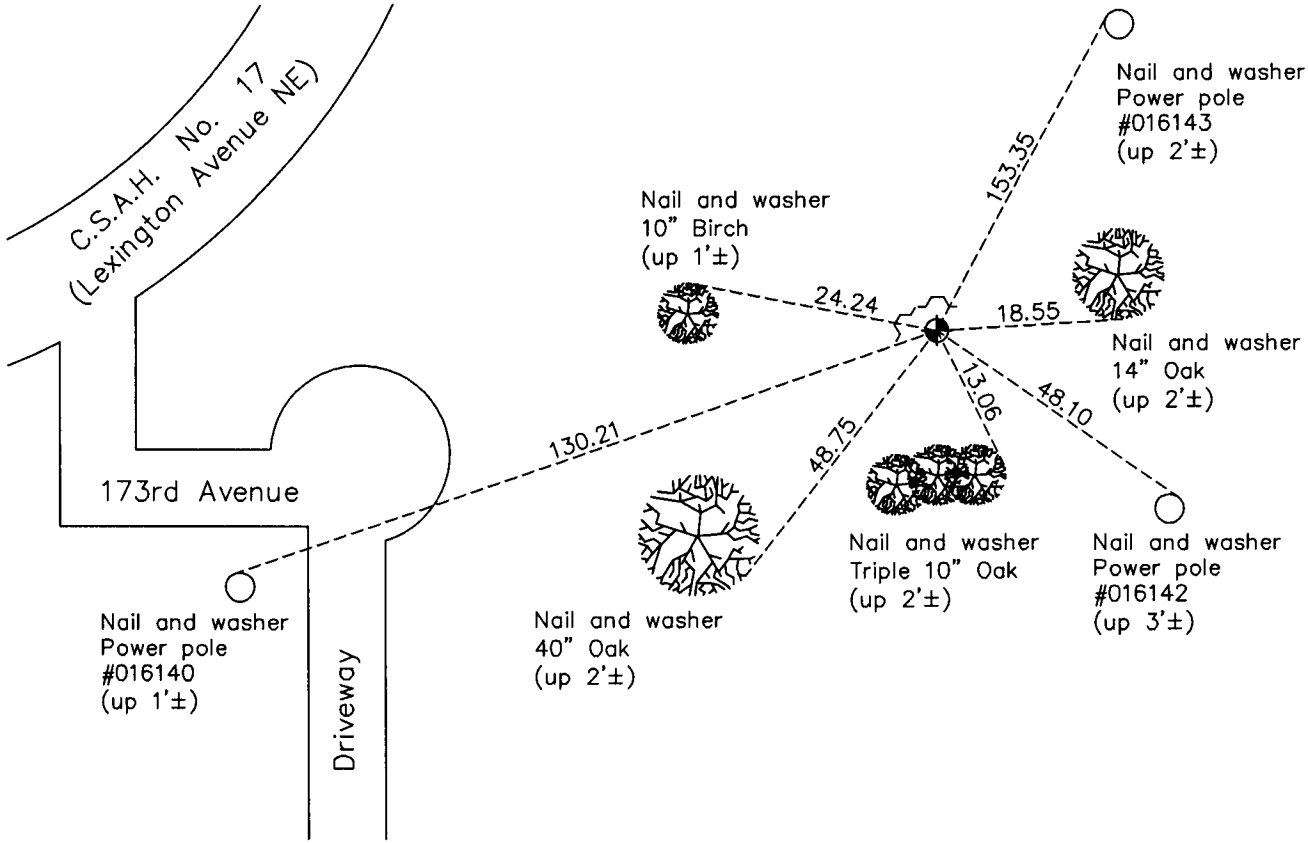


Revision Date
8/31/11

N.A.D. 1983 Coordinates
 (1996 Adjustment)

County Project Coordinates	
Northing	<u>190396.8850</u>
Easting	<u>532039.4622</u>
Date	<u>8/06/96</u>

I hereby certify that this United States public land survey monument record is correct and complete to the best of my knowledge and belief.

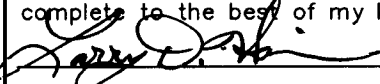 Date 8/31/11

Larry D. Hoium, Anoka County Surveyor
 Minnesota License Number 18165