

# CERTIFICATE OF LOCATION OF GOVERNMENT CORNER

County of Anoka

State of Minnesota



## Southwest Corner of Sec. 3 Township 32 Range 23

On the 4th day of January, 1961, the described corner was evidenced by an iron pipe

and to perpetuate the location of said corner, at the exact location thereof, a permanent marker was placed consisting of a cast iron monument

AND on the 8th day of April, 2011, said permanent marker was found and the ties  
were updated

Updated reference ties are as shown below.

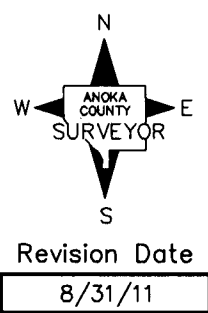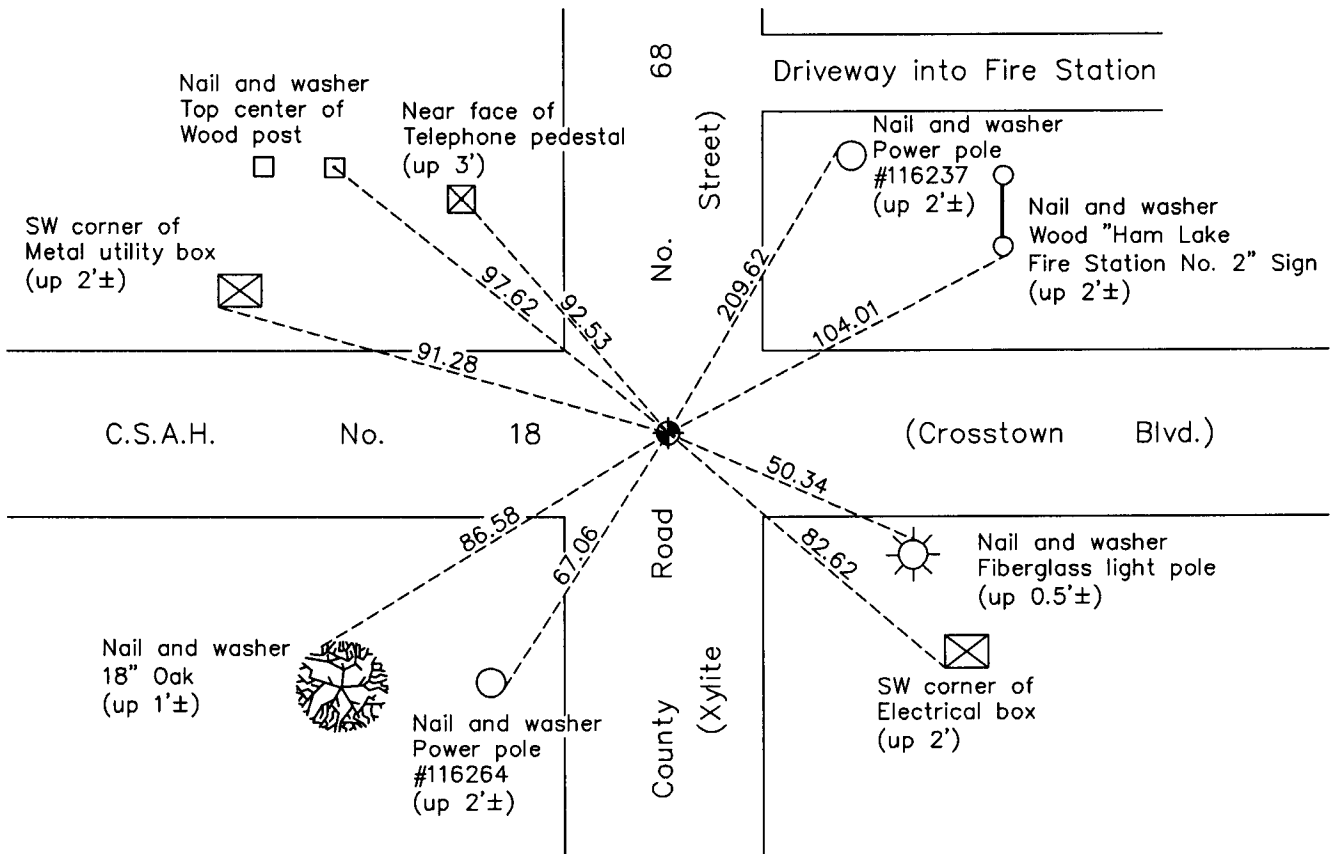

N.A.D. 1983 Coordinates  
 (1996 Adjustment)

County Project Coordinates	
Northing	190739.6746
Easting	516056.0586
Date	1/24/02

I hereby certify that this United States public land survey monument record is correct and complete to the best of my knowledge and belief.

*Larry D. Hoium* Date 8/31/11

Larry D. Hoium, Anoka County Surveyor

Minnesota License Number 18165