

CERTIFICATE OF LOCATION OF GOVERNMENT CORNER

County of Anoka

State of Minnesota



West 1/4 Corner of Sec. 8 Township 32 Range 23

On the 16th day of October, 1961, the described corner was evidenced by a 1/2" iron pipe

and to perpetuate the location of said corner, at the exact location thereof, a permanent marker was placed consisting of a cast iron monument

AND on the 29th day of April, 2011, said permanent marker was found and the ties were updated. A sign and post was set on the south side.

Updated reference ties are as shown below.

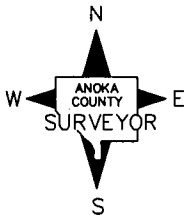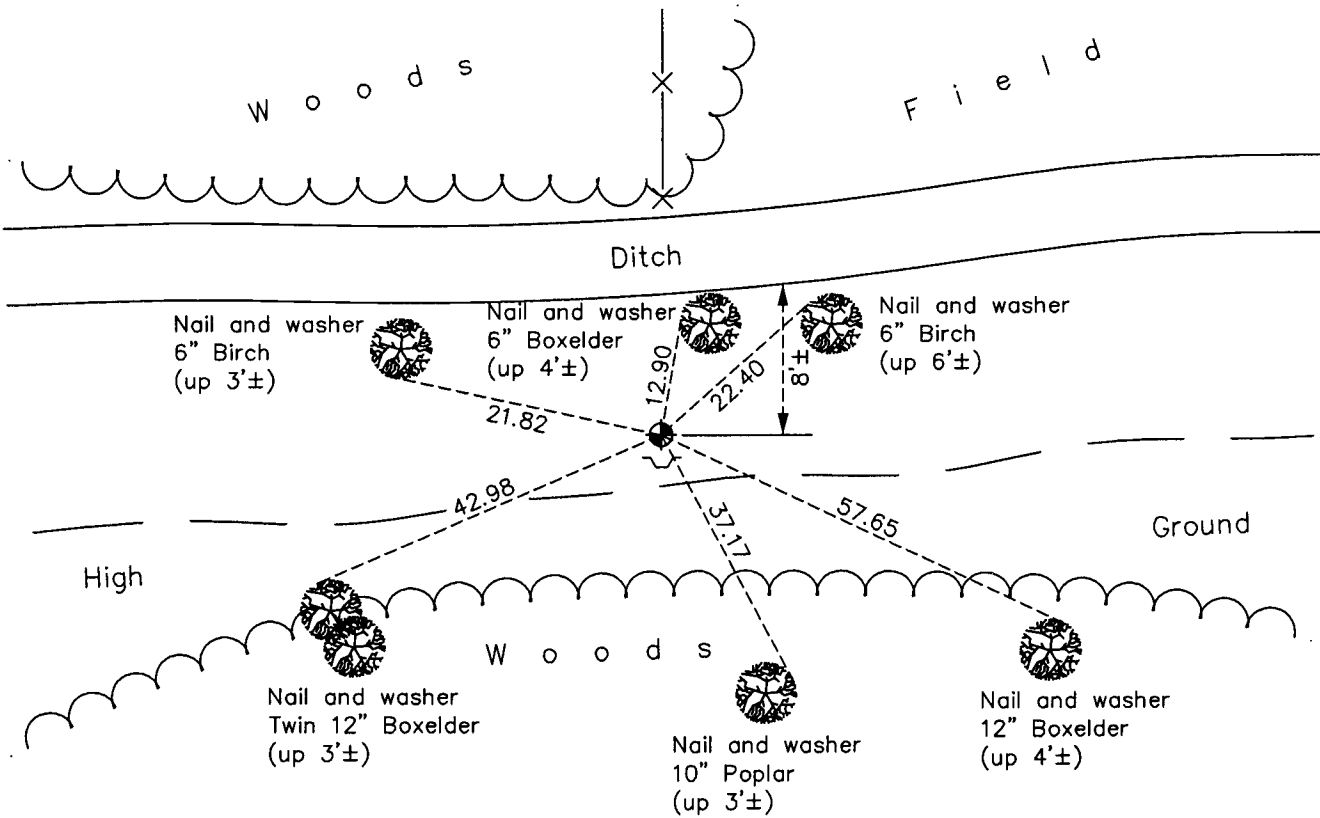

Revision Date
 9/02/11

N.A.D. 1983 Coordinates
 (1996 Adjustment)

County Project Coordinates	
Northing	188124.4951
Easting	505474.2237
Date	2/11/02

I hereby certify that this United States public land survey monument record is correct and complete to the best of my knowledge and belief.

Larry D. Hoium Date 9/02/11

Larry D. Hoium, Anoka County Surveyor
 Minnesota License Number 18165