

CERTIFICATE OF LOCATION OF GOVERNMENT CORNER

County of Anoka

State of Minnesota



East 1/4 Corner of Sec. 8 Township 32 Range 23

On the 5th day of March, 1962, the described corner was evidenced by a 1" iron pipe

and to perpetuate the location of said corner, at the exact location thereof, a permanent marker was placed consisting of a cast iron monument

AND on the 20th day of May, 2011, said permanent marker was found broken down 2'± and leaning SE. Set new CIM on top 0.08' N and 0.08' W of broken CIM. The ties were updated.

Updated reference ties are as shown below.

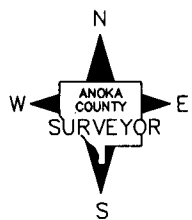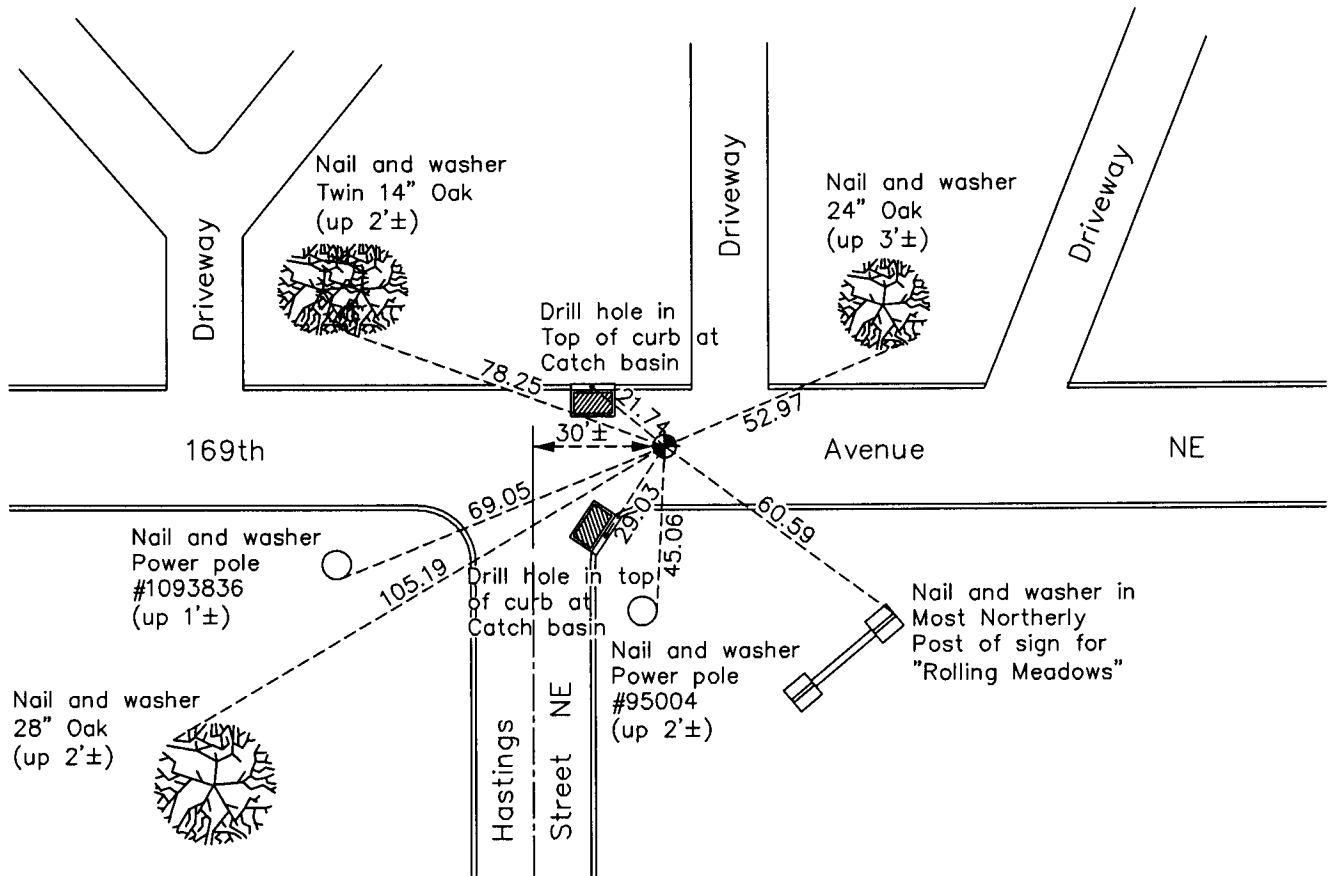

N.A.D. 1983 Coordinates
(1996 Adjustment)

County Project Coordinates	
Northing	188223.1637
Easting	510806.0427
Date	11/28/01

I hereby certify that this United States public land survey monument record is correct and complete to the best of my knowledge and belief.

Larry D. Hoium Date 9/07/11
 _____, Anoka County Surveyor
 Minnesota License Number 18165

Revision Date
9/07/11