## CERTIFICATE OF LOCATION OF GOVERNMENT CORNER

County of Anoka


State of Minnesota

## West 1/4 Corner of Sec. 12 Township 32 Range 23

I hereby certify that on the <u>22nd</u> day of <u>November</u>, <u>1965</u>, I found the described corner which was evidenced by <u>area resurvey</u>

and I further certify that to perpetuate the location of said corner, I did, at the exact location thereof, place a permanent marker consisting of <u>a cast iron monument down 1' more or less</u>

which reference or witness monuments are located in the manner following:

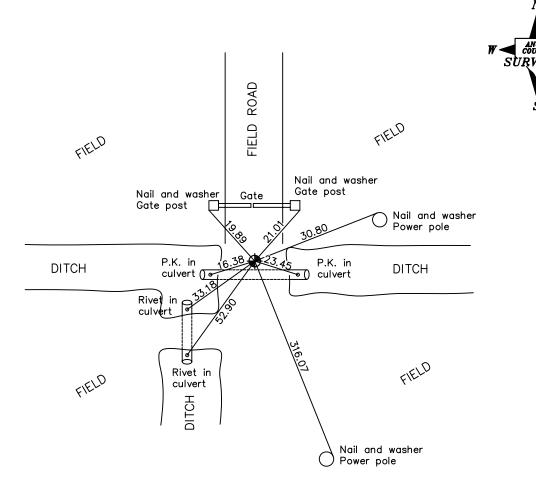

## Revised date

9/19/91
8/15/96
1/28/02

N.A.D. 1983 Coordinates (1996 adjustment)

County Project Coordinates	State Plane Coordinates
Northing <u>188129.6858</u> Easting <u>526822.8815</u>	X
Date 1	/28/02