

CERTIFICATE OF LOCATION OF GOVERNMENT CORNER

County of Anoka State of Minnesota



South 1/4 Corner of Sec. 11 Township 32 Range 23

On the 15th day of July, 1966, the described corner was evidenced by area resurvey

and to perpetuate the location of said corner, at the exact location thereof, a permanent marker was placed consisting of a cast iron monument

AND on the 30th day of March, 2011, said permanent marker was found down 0.3'± and the ties were updated. On April 27, 2011 set sign and post on east side.

Updated reference ties are as shown below.

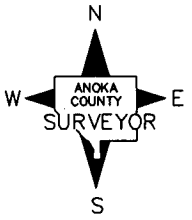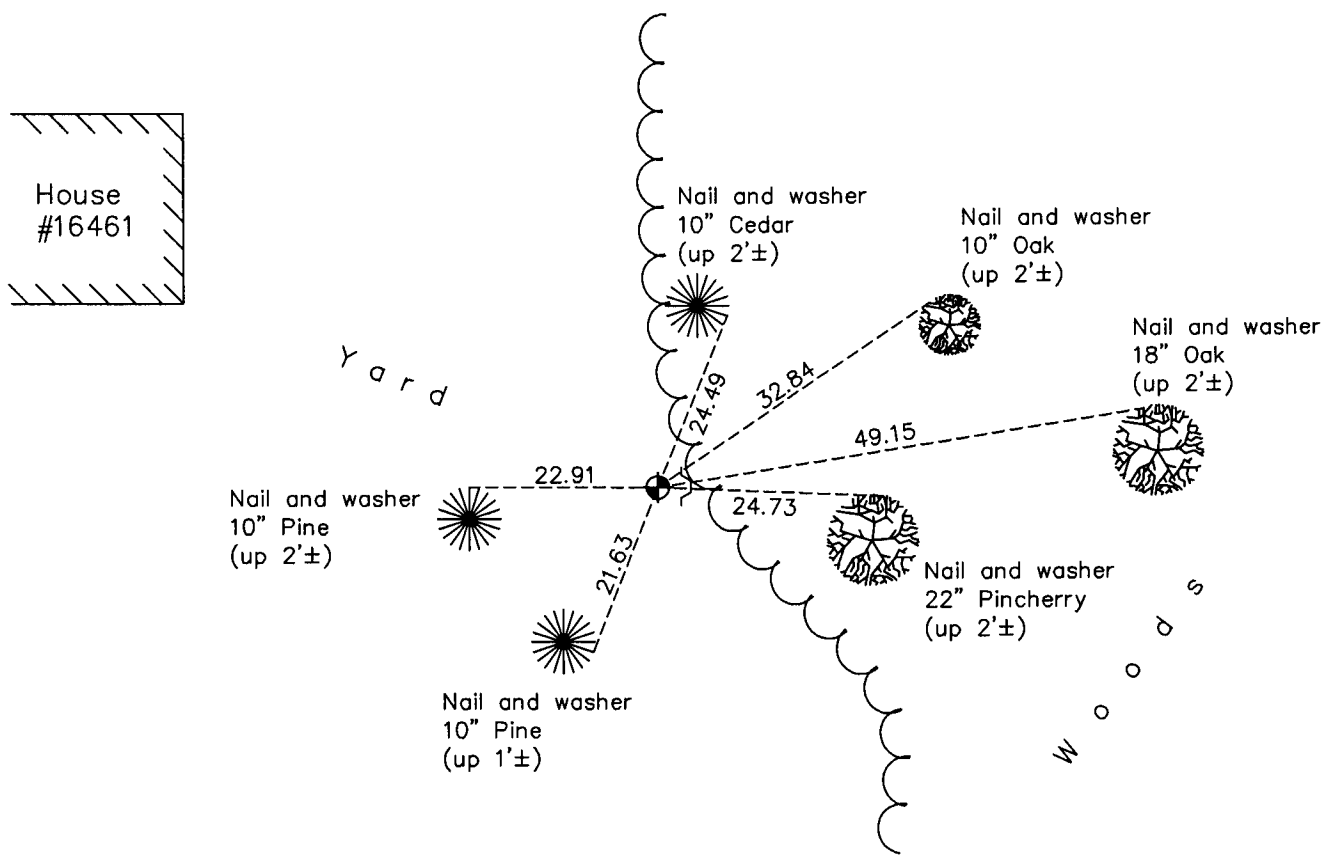

Revision Date
 9/12/11

N.A.D. 1983 Coordinates
(1996 Adjustment)

County Project Coordinates	
Northing	185355.7410
Easting	524150.8121
Date	9/05/01

I hereby certify that this United States public land survey monument record is correct and complete to the best of my knowledge and belief.

Larry D. Hoium Date 9/12/11
 Larry D. Hoium, Anoka County Surveyor
 Minnesota License Number 18165