## CERTIFICATE OF LOCATION OF GOVERNMENT CORNER

County of Anoka

State of Minnesota


## Sixteenth Corner of Sec. 10 Township 32 Range 23

I hereby certify that on the <u>13th</u> day of <u>February</u>, <u>1961</u>, I found the described corner which was evidenced by <u>a 6" X 6" granite monument</u>

and I further certify that to perpetuate the location of said corner, I did, at the exact location thereof, place a permanent marker consisting of the above described 6" X 6" granite monument

which reference or witness monuments are located in the manner following:



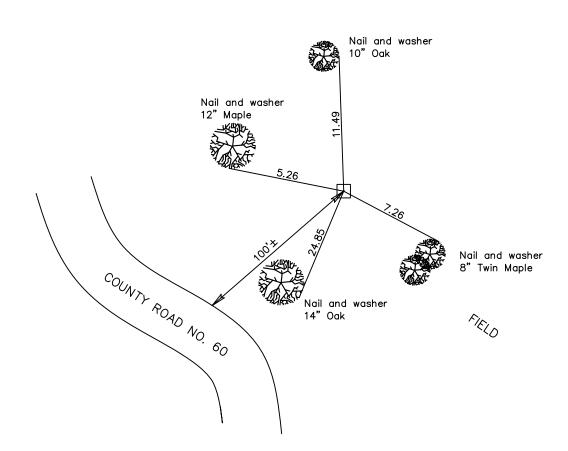

## Revised date

6/25/81	
11/19/91	

N.A.D. 1983 Coordinates (1996 adjustment)

County Project Coordinates	State Plane Coordinates	
Northing <u>185327.7554</u> Easting <u>520147.4813</u>	X	
Date 9/04/01		