

CERTIFICATE OF LOCATION OF GOVERNMENT CORNER

County of Anoka

State of Minnesota



West 1/4 Corner of Sec. 16 Township 32 Range 23

On the 14th day of May, 1960, the described corner was evidenced by a concrete monument

and to perpetuate the location of said corner, at the exact location thereof, a permanent marker was placed consisting of a cast iron monument

AND on the 25th day of February, 2011, said permanent marker was found down 0.3'± and the ties were updated

Updated reference ties are as shown below.

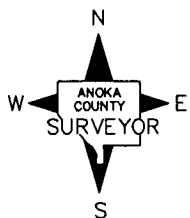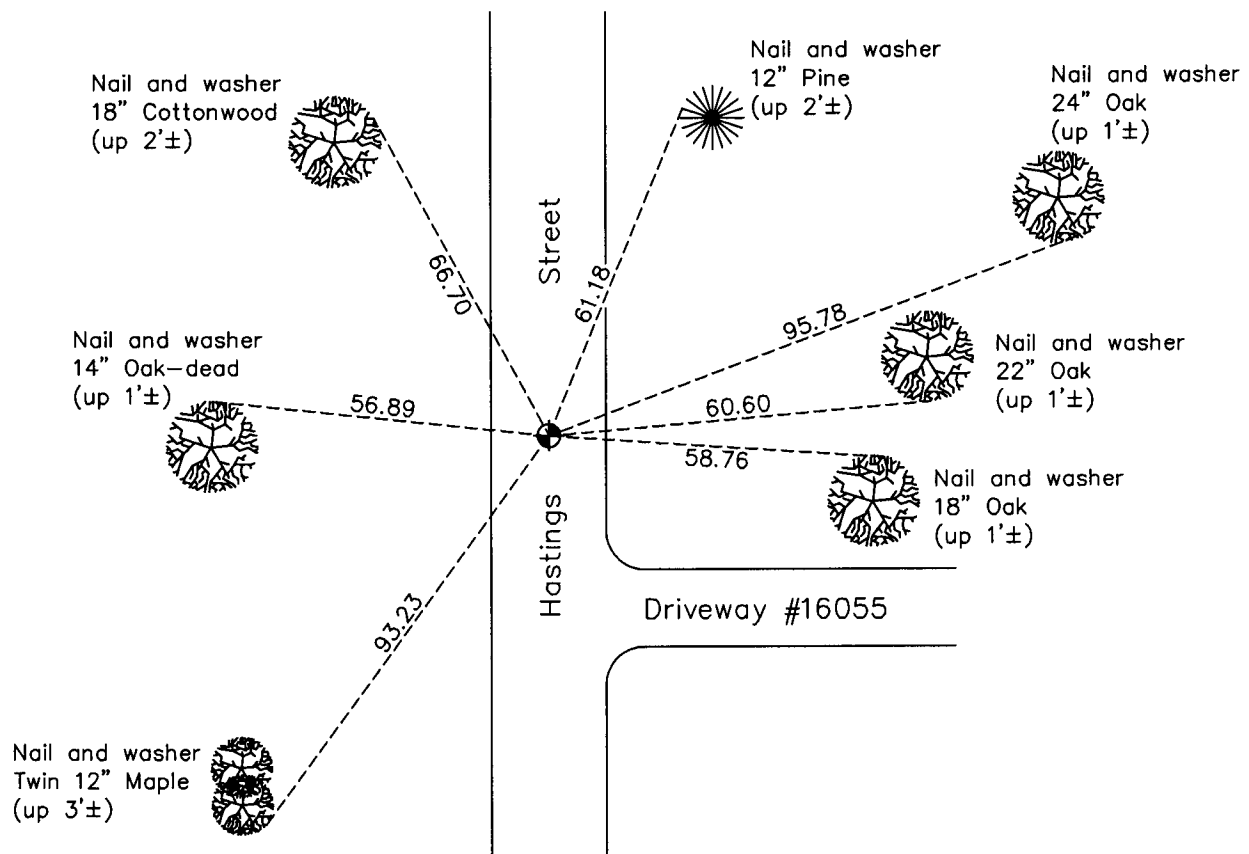

N.A.D. 1983 Coordinates
(1996 Adjustment)

County Project Coordinates	
Northing	<u>182933.2784</u>
Easting	<u>510842.5283</u>
Date	<u>11/20/01</u>

Revision Date
9/14/11

I hereby certify that this United States public land survey monument record is correct and complete to the best of my knowledge and belief.

Larry D. Hoium Date 9/14/11

Larry D. Hoium, Anoka County Surveyor

Minnesota License Number 18165