

CERTIFICATE OF LOCATION OF GOVERNMENT CORNER

County of Anoka

State of Minnesota



East 1/4 Corner of Sec. 16 Township 32 Range 23

On the 30th day of August, 1967, the described corner was evidenced by a concrete monument

and to perpetuate the location of said corner, at the exact location thereof, a permanent marker was placed consisting of a cast iron monument

AND on the 28th day of February, 2011, said permanent marker was found and the ties were updated

Updated reference ties are as shown below.

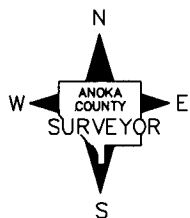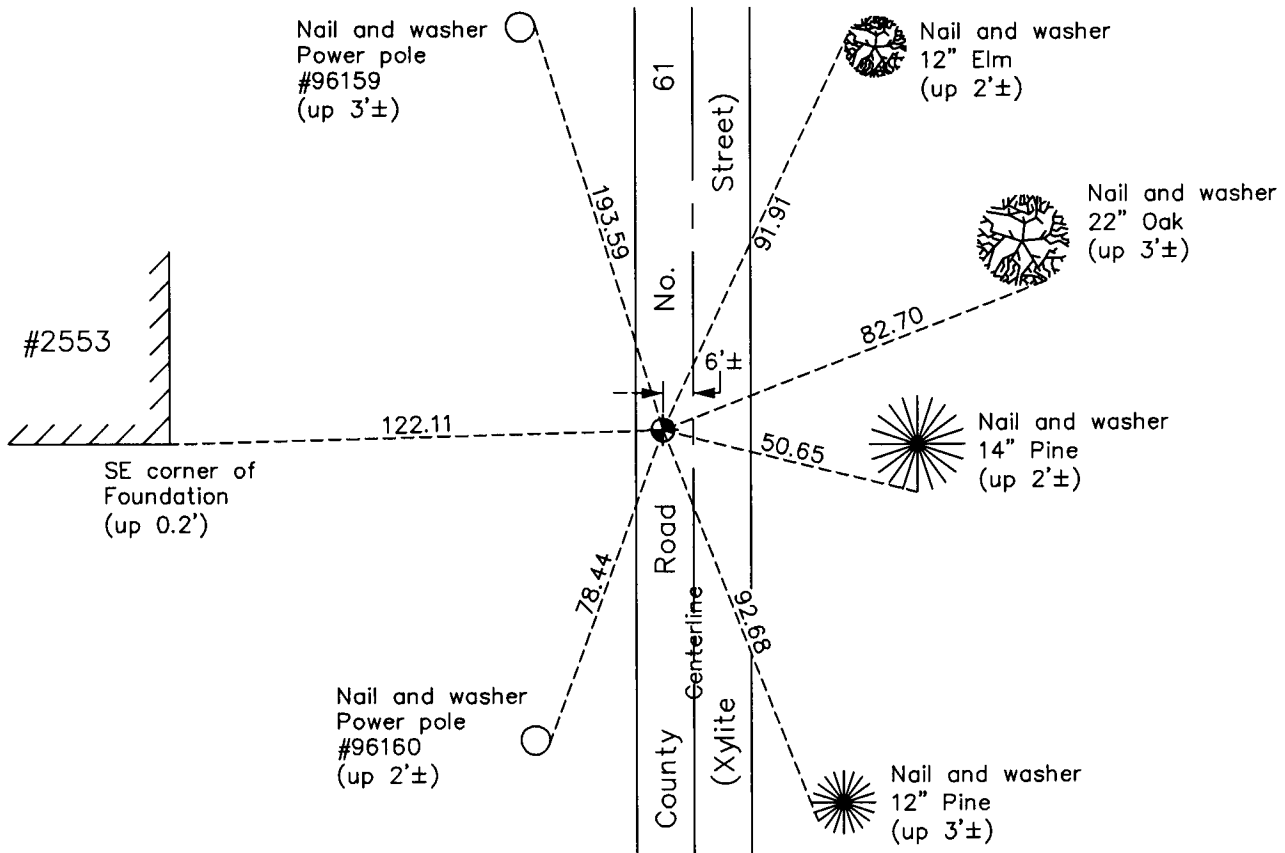

Revision Date

9/14/11

N.A.D. 1983 Coordinates
(1996 Adjustment)

County Project Coordinates

Northing 182794.0506

Easting 516109.8902

Date 9/18/01

I hereby certify that this United States public land survey monument record is correct and complete to the best of my knowledge and belief.

Larry D. Hoium Date 9/14/11

Larry D. Hoium, Anoka County Surveyor

Minnesota License Number 18165