

CERTIFICATE OF LOCATION OF GOVERNMENT CORNER

County of Anoka

State of Minnesota



West 1/4 Corner of Sec. 13 Township 32 Range 23

On the 1st day of December, 1965, the described corner was evidenced by area resurvey

and to perpetuate the location of said corner, at the exact location thereof, a permanent marker was placed consisting of a cast iron monument

AND on the 23rd day of May, 2011, said permanent marker was found broken and was replaced with a new cast iron monument with sign & post on east side and the ties were updated

Updated reference ties are as shown below.

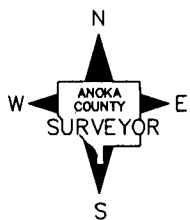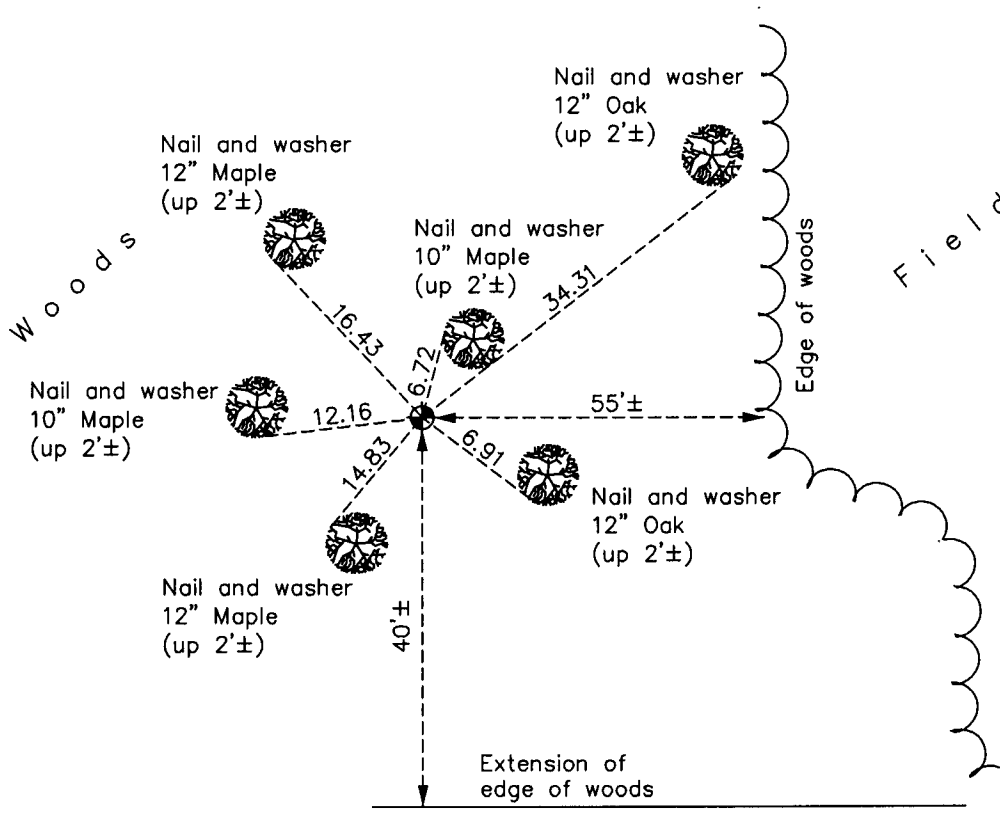

N.A.D. 1983 Coordinates
(1996 Adjustment)

County Project Coordinates	
Northing	182700.2440
Easting	526790.0251
Date	12/12/02

I hereby certify that this United States public land survey monument record is correct and complete to the best of my knowledge and belief.

Date 9/15/11
 _____, Anoka County Surveyor
 Minnesota License Number 18165

Revision Date
9/15/11