
CERTIFICATE OF LOCATION OF GOVERNMENT CORNER

County of Anoka

State of Minnesota

East 1/4 Corner of Sec. 13 Township 32 Range 23

								_	
l hereby certif	y that on the	e <u>4th</u> day of _	March	, <u>1976</u> , I	found	the descr	ibed corner	which	was
evidenced by	area resurvey	/							
and I further	certify that to	o perpetuate 1	the location	of said	corner,	I did, at	the exact	location	<u> </u>
thereof, place	a permanent	marker consi	sting of <u>a</u>	red and	white in	ron pipe			
which reference	ce or witness	monuments a	re located	in the mo	anner fo	ollowing:		N	
	ı	ı					₩ <	ANORA COUNTY URVEY	$\sum E$
							S	UKVEYÇ	ĮΚ

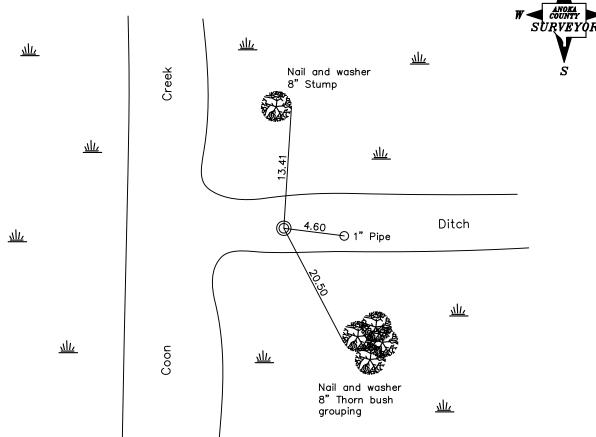

Revised date

7/09/87
2/13/02

N.A.D. 1983 Coordinates (1996 adjustment)

County Project Coordinates	State Plane Coordinates				
Northing <u>182525.0648</u>	Y				
Easting <u>532035.8847</u>	X				
 Date 2/13/02					