

CERTIFICATE OF LOCATION OF GOVERNMENT CORNER

County of Anoka

State of Minnesota



Witness Corner of Sec. 13 Township 32 Range 23
 (20.00' east of SE corner of section)

On the 3rd day of March, 1976, the described corner was evidenced by a concrete monument

and to perpetuate the location of said corner, at the exact location thereof, a permanent marker was placed consisting of the same concrete monument with a sign and post on the north side

AND on the 6th day of May, 2011, said permanent marker was found broken and was replaced w/ red & white 2" sq. steel Telspar mon't. up 1.0'± w/ 'County Surveyor' cap & punchmark.

Updated reference ties are as shown below.

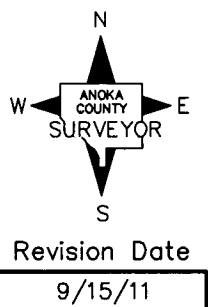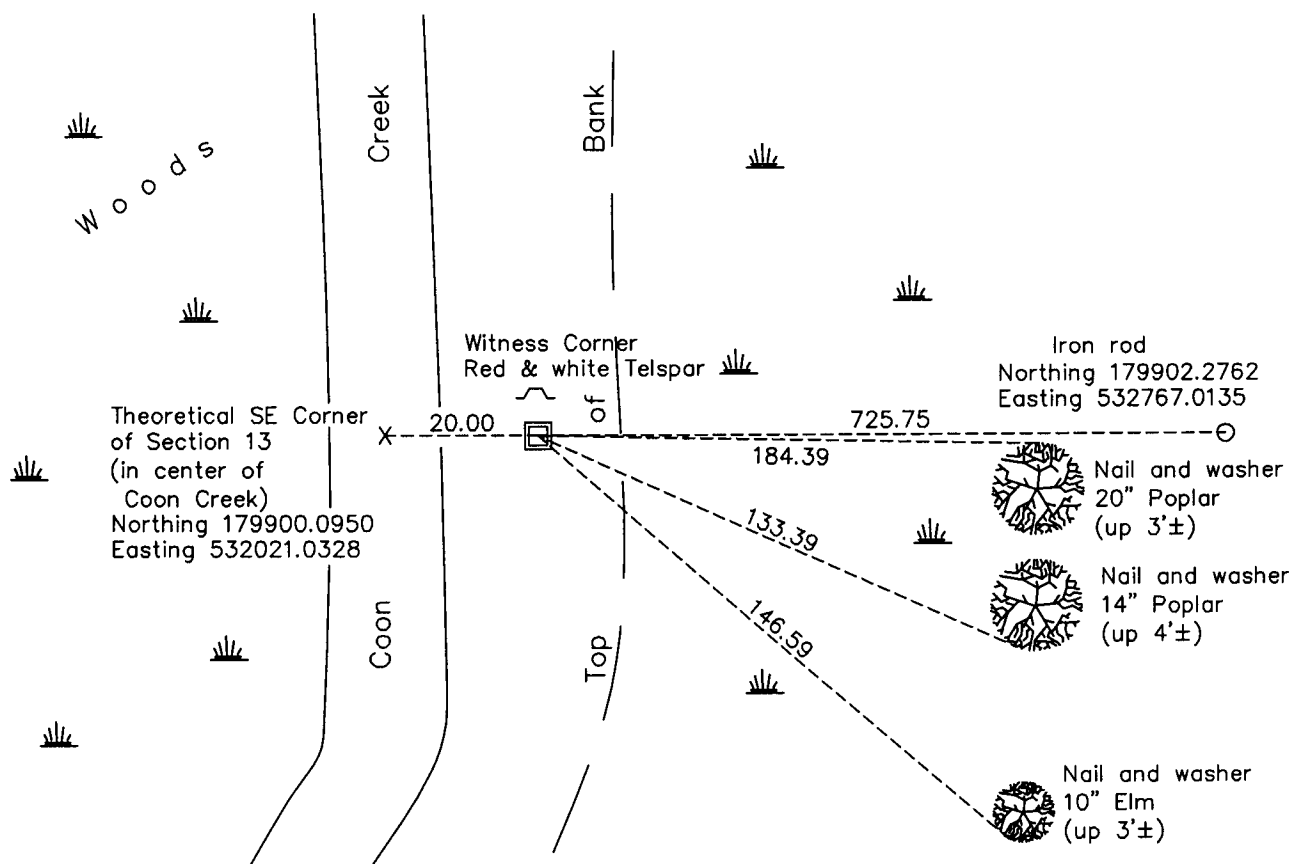

N.A.D. 1983 Coordinates
(1996 Adjustment)

County Project Coordinates	
Northing	179900.1535
Easting	532041.0327
Date	2/13/02

I hereby certify that this United States public land survey monument record is correct and complete to the best of my knowledge and belief.

Larry D. Hoium Date 9/15/11

Larry D. Hoium, Anoka County Surveyor

Minnesota License Number 18165