

CERTIFICATE OF LOCATION OF GOVERNMENT CORNER

County of Anoka

State of Minnesota


Meander Corner of Sec. 17 Township 32 Range 23 (on east side of island)

On the 2nd day of July, 1959, the described corner was evidenced by a one inch iron pipe

and to perpetuate the location of said corner, at the exact location thereof, a permanent marker was placed consisting of the same iron pipe

AND on the 29th day of April, 2011, said permanent marker was an iron pipe with brass cap labeled "US General Land Office Survey-6161" and was leaning NE 0.3'±. The ties were updated.

Updated reference ties are as shown below.

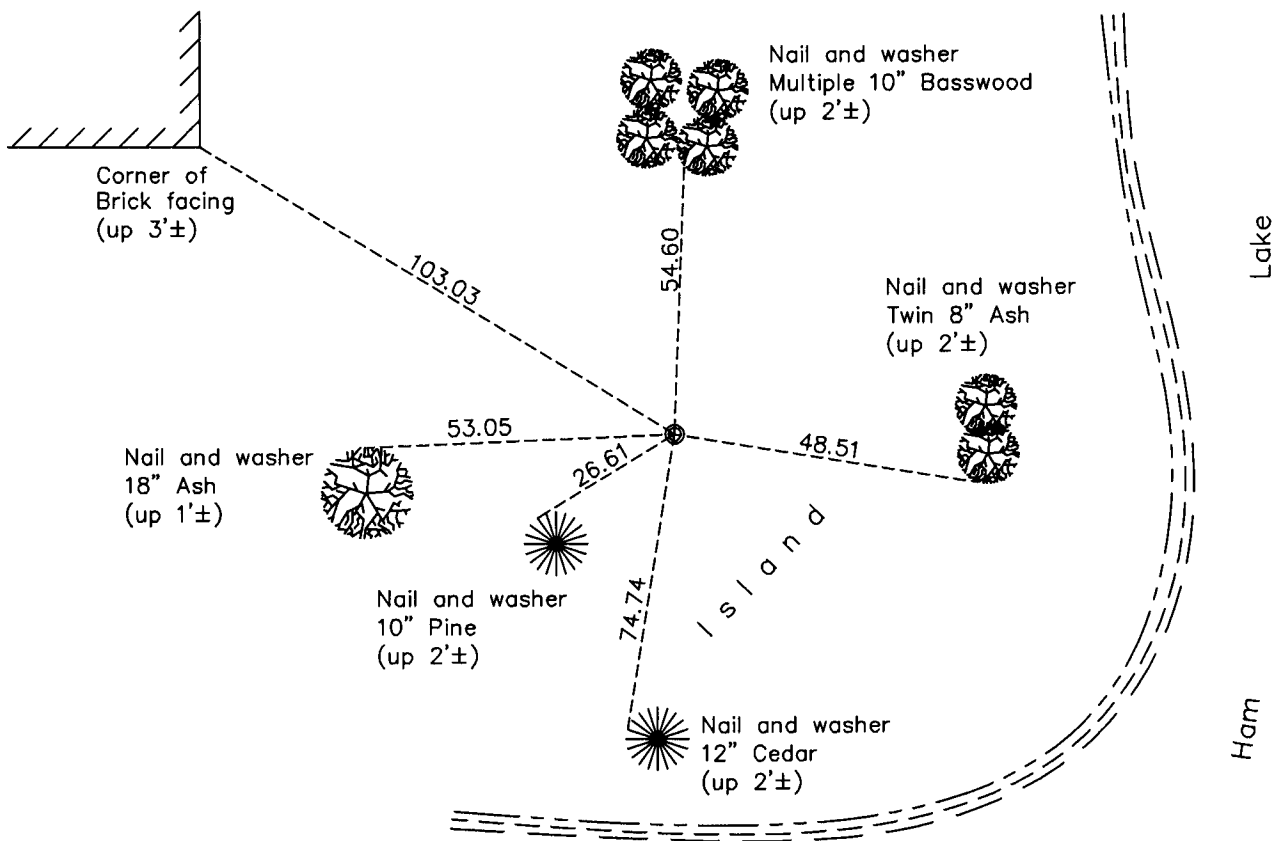

Revision Date

9/19/11

N.A.D. 1983 Coordinates
(1996 Adjustment)

County Project Coordinates	
Northing	180246.9442
Easting	510819.8478
Date	2/05/02

I hereby certify that this United States public land survey monument record is correct and complete to the best of my knowledge and belief.

Larry D. Hoium Date 9/19/11

Larry D. Hoium, Anoka County Surveyor

Minnesota License Number 18165