

# CERTIFICATE OF LOCATION OF GOVERNMENT CORNER

County of Anoka

State of Minnesota



## Meander #9 Corner of Sec. 16 Township 32 Range 23 (on south line of section)

On the 10th day of June, 1960, the described corner was evidenced by a concrete monument

and to perpetuate the location of said corner, at the exact location thereof, a permanent marker was placed consisting of the same concrete monument with a sign and post on the south side

AND on the 28th day of February, 2011, said permanent marker was found up 0.1'± and the ties were updated

Updated reference ties are as shown below.

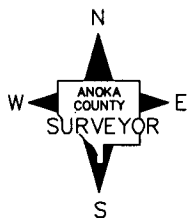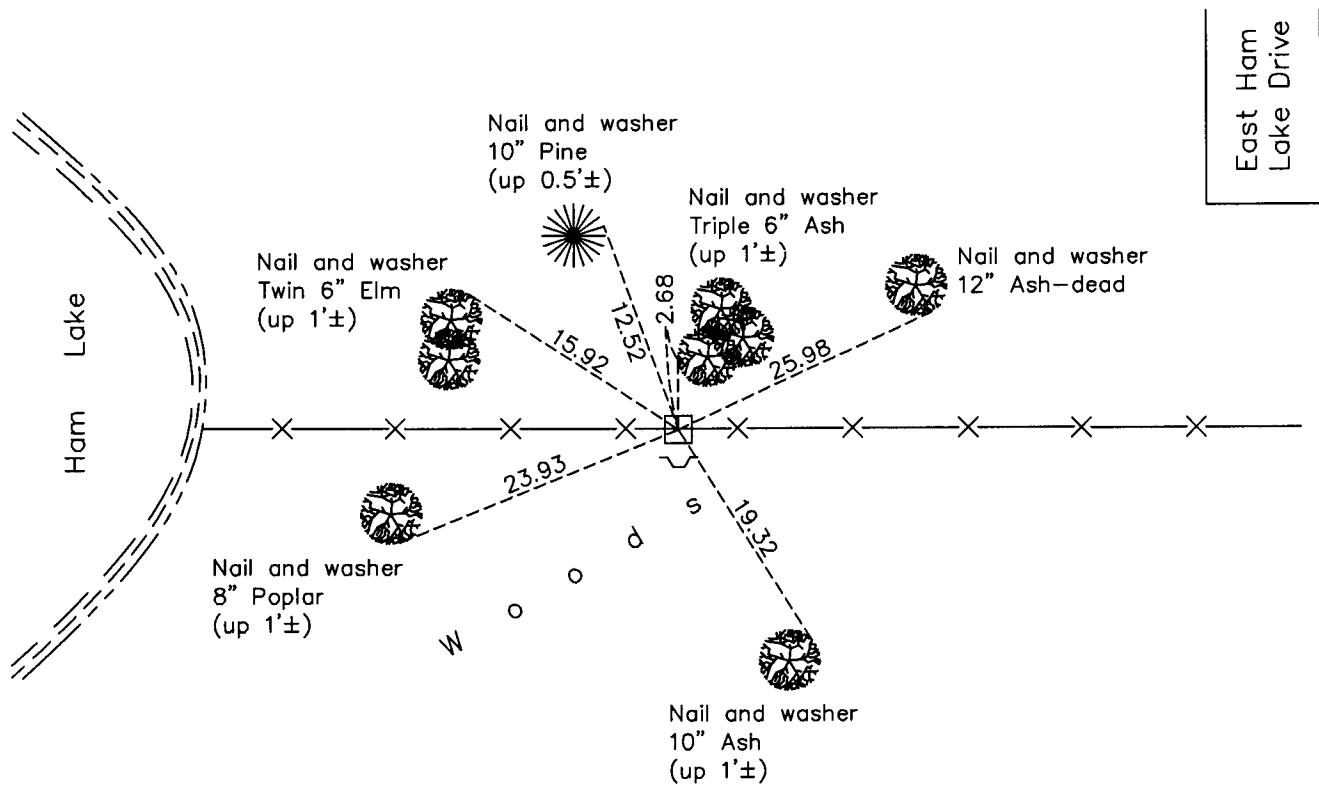

N.A.D. 1983 Coordinates  
(1996 Adjustment)

**County Project Coordinates**

Northing 180263.6848

Easting 512706.3997

Date 2/05/02

I hereby certify that this United States public land survey monument record is correct and complete to the best of my knowledge and belief.

*Larry D. Hoium* Date 9/19/11

Larry D. Hoium, Anoka County Surveyor

Minnesota License Number 18165

Revision Date

9/19/11