

CERTIFICATE OF LOCATION OF GOVERNMENT CORNER

County of Anoka

State of Minnesota



Meander Corner of Sec. 20 Township 32 Range 23 (on north line of NE1/4)

On the 25th day of September, 1961, the described corner was evidenced by a sandstone monument

and to perpetuate the location of said corner, at the exact location thereof, a permanent marker was placed consisting of an iron pipe with a bronze cap

AND on the 29th day of April, 2011, said permanent marker was found and the ties were updated

Updated reference ties are as shown below.

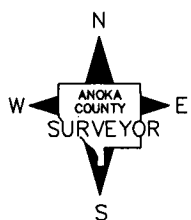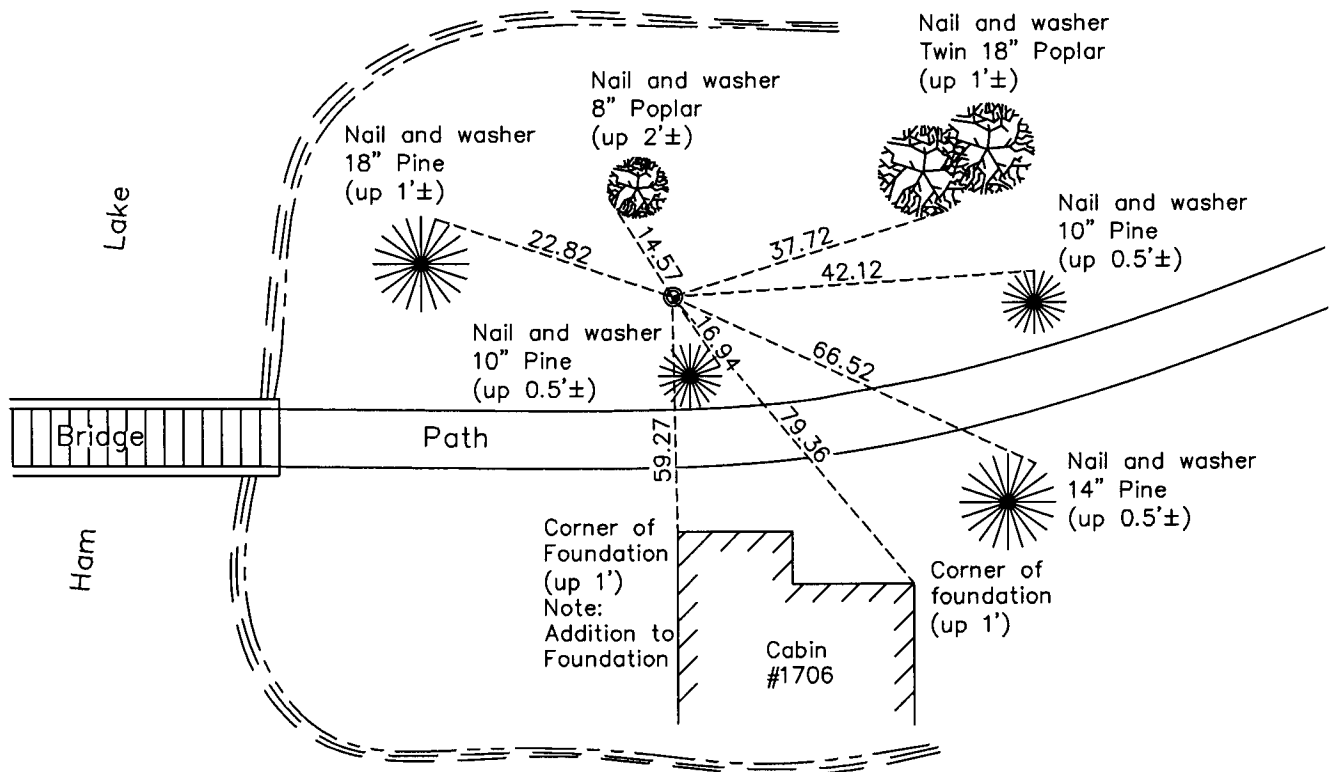

Revision Date

9/20/11

N.A.D. 1983 Coordinates
(1996 Adjustment)

County Project Coordinates	
Northing	180249.1391
Easting	510256.7827
Date	2/05/02

I hereby certify that this United States public land survey monument record is correct and complete to the best of my knowledge and belief.

Larry D. Hoium Date 9/20/11

Larry D. Hoium, Anoka County Surveyor

Minnesota License Number 18165