

CERTIFICATE OF LOCATION OF GOVERNMENT CORNER

County of Anoka

State of Minnesota



East 1/4 Corner of Sec. 24 Township 32 Range 23

On the 3rd day of May, 1965, the described corner was evidenced by a concrete monument

and to perpetuate the location of said corner, at the exact location thereof, a permanent marker was placed consisting of the same concrete monument (top broken) with a sign and post on the north side

AND on the 22nd day of April, 2011, said permanent marker was found with a spike in the top center of the monument and the ties were updated

Updated reference ties are as shown below.

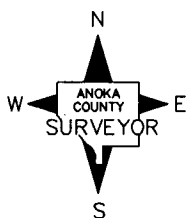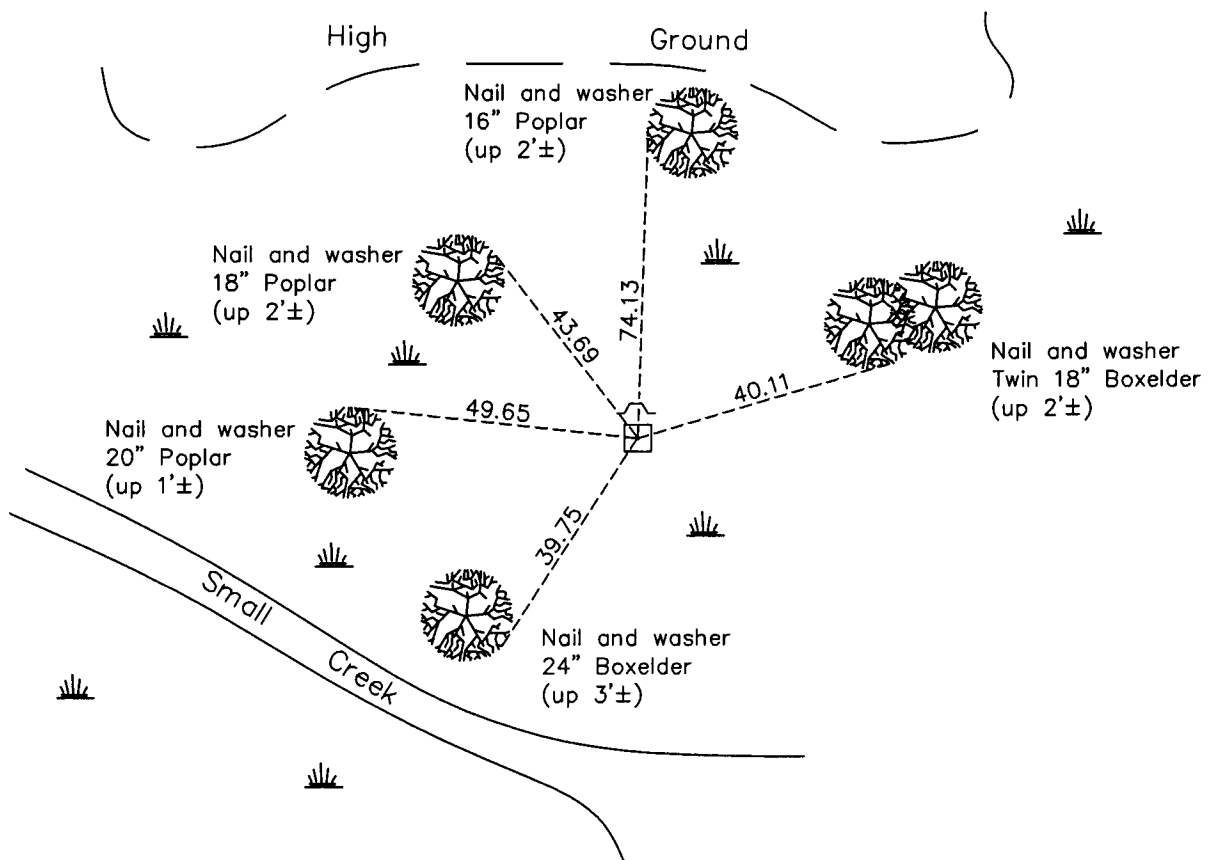

Revision Date

9/23/11

N.A.D. 1983 Coordinates
(1996 Adjustment)

County Project Coordinates	
Northing	177270.4909
Easting	532027.6748
Date	3/05/02

I hereby certify that this United States public land survey monument record is correct and complete to the best of my knowledge and belief.

Larry D. Hoium Date 9/23/11

Larry D. Hoium, Anoka County Surveyor

Minnesota License Number 18165