CERTIFICATE OF LOCATION OF GOVERNMENT CORNER

County of Anoka


State of Minnesota

Southeast Corner of Sec. 24 Township 32 Range 23

I hereby certify that on the <u>3rd</u> day of <u>May</u>, <u>1965</u>, I found the described corner which was evidenced by <u>a concrete monument</u>

and I further certify that to perpetuate the location of said corner, I did, at the exact location thereof, place a permanent marker consisting of a concrete monument (up 1' \pm and broken off) with sign and post on the north side

which reference or witness monuments are located in the manner following:

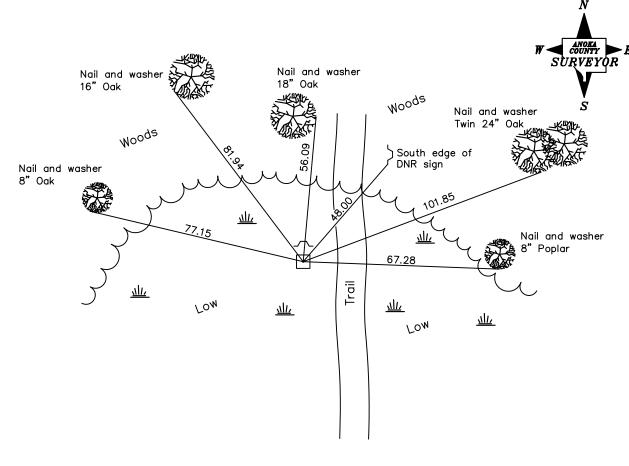

Revised date

2/11/94	
3/04/02	
	_

N.A.D. 1983 Coordinates (1996 adjustment)

County Project Coordinates	State Plane Coordinates
Northing <u>174638.4826</u> Easting <u>532026.3538</u>	X
Date 3,	