

# CERTIFICATE OF LOCATION OF GOVERNMENT CORNER

County of Anoka

State of Minnesota



## South 1/4 Corner of Sec. 24 Township 32 Range 23

On the \_\_\_\_ day of November, 1965, the described corner was evidenced by area resurvey

and to perpetuate the location of said corner, at the exact location thereof, a permanent marker was placed consisting of a cast iron monument with a sign and post on the east side

AND on the 4th day of March, 2011, said permanent marker was found down 0.4'± and the ties were updated

Updated reference ties are as shown below.

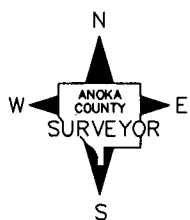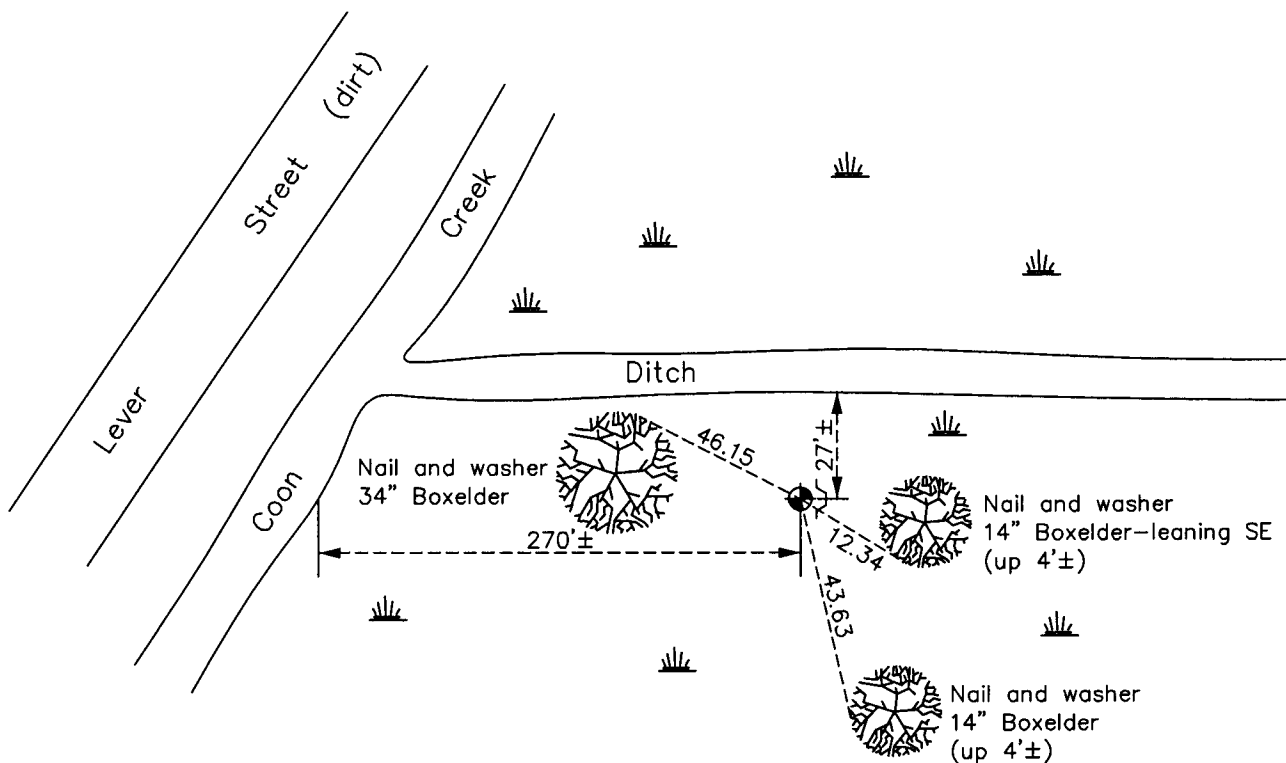

N.A.D. 1983 Coordinates  
(1996 Adjustment)

County Project Coordinates

Northing 174676.9953

Easting 529367.8536

Date 5/05/05

I hereby certify that this United States public land survey monument record is correct and complete to the best of my knowledge and belief.

*Larry D. Hoium* Date 9/23/11

Larry D. Hoium, Anoka County Surveyor

Minnesota License Number 18165

Revision Date

9/23/11