

# CERTIFICATE OF LOCATION OF GOVERNMENT CORNER

County of Anoka

State of Minnesota



## Southwest Corner of Sec. 20 Township 32 Range 23

On the 30th day of September, 1959, the described corner was evidenced by a 1 1/2" iron pipe

and to perpetuate the location of said corner, at the exact location thereof, a permanent marker was placed consisting of a red and white 2" square steel Telspar monument with a sign attached on the west side

AND on the 18th day of March, 2011, said permanent marker was found up 4'± and the ties were updated

Updated reference ties are as shown below.

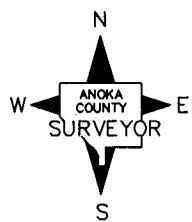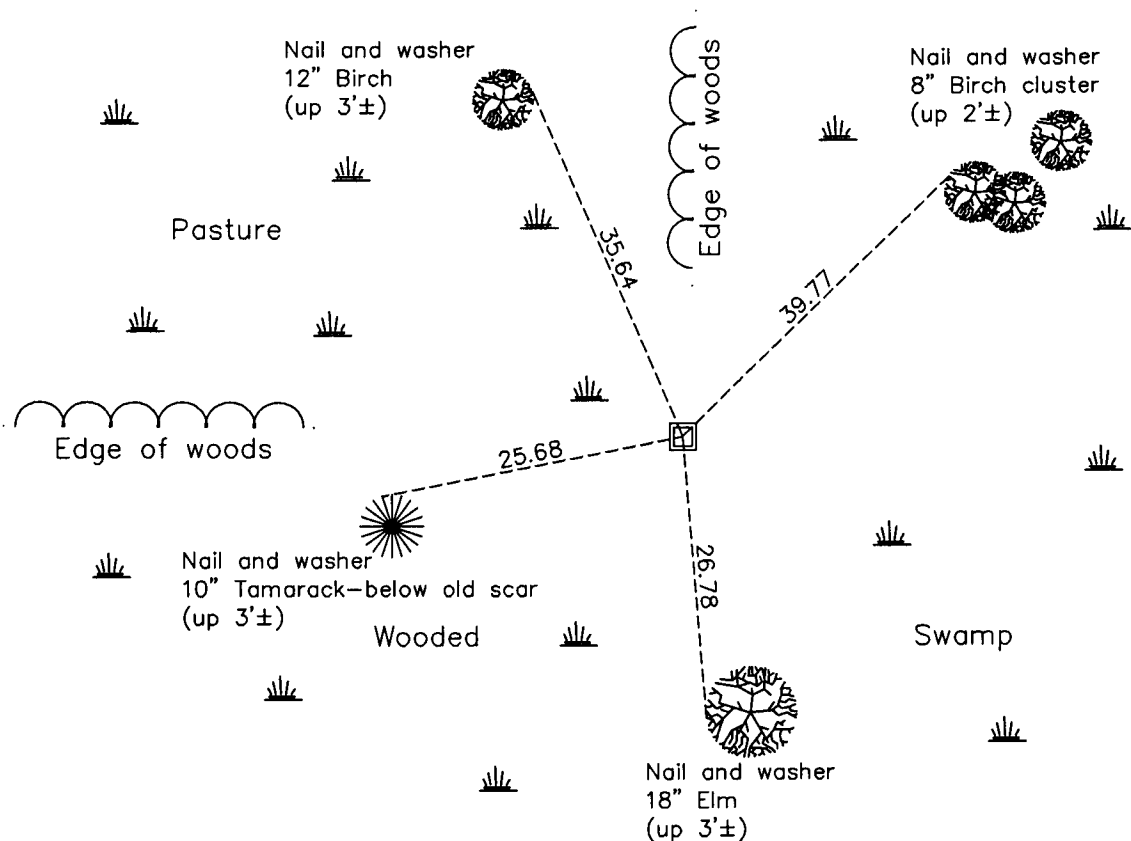

N.A.D. 1983 Coordinates  
(1996 Adjustment)

**County Project Coordinates**

Northing 174866.7772

Easting 505489.8804

Date 2/06/02

I hereby certify that this United States public land survey monument record is correct and complete to the best of my knowledge and belief.

*Larry D. Hoium* Date 9/27/11

Larry D. Hoium, Anoka County Surveyor

Minnesota License Number 18165

Revision Date

9/27/11