

CERTIFICATE OF LOCATION OF GOVERNMENT CORNER

County of Anoka

State of Minnesota



East 1/4 Corner of Sec. 30 Township 32 Range 23

On the 12th day of September, 1960, the described corner was evidenced by a concrete monument

and to perpetuate the location of said corner, at the exact location thereof, a permanent marker was placed consisting of a cast iron monument

AND on the 7th day of April, 2011, said permanent marker was found up 0.2'± and the ties were updated

Updated reference ties are as shown below.

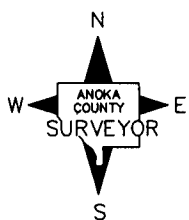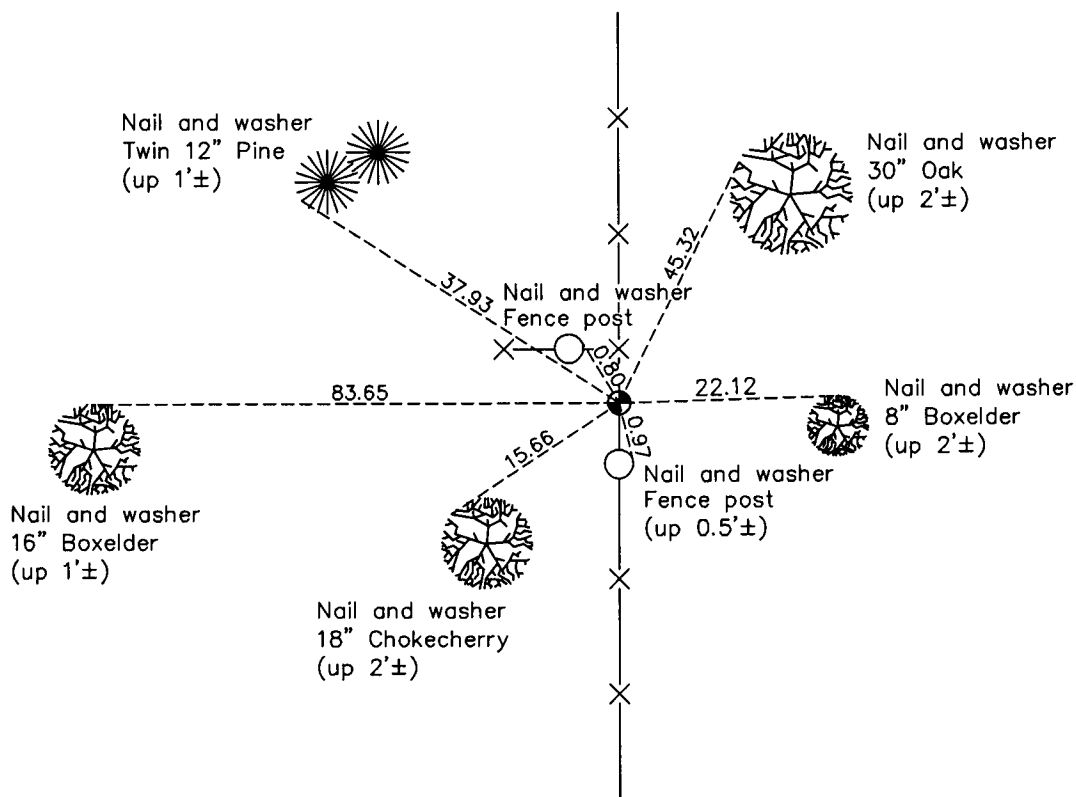

Revision Date
9/28/11

N.A.D. 1983 Coordinates
(1996 Adjustment)

County Project Coordinates	
Northing	172215.4195
Easting	505509.2546
Date	12/20/01

I hereby certify that this United States public land survey monument record is correct and complete to the best of my knowledge and belief.

Larry D. Hoium Date 9/28/11

Larry D. Hoium, Anoka County Surveyor

Minnesota License Number 18165