

CERTIFICATE OF LOCATION OF GOVERNMENT CORNER

County of Anoka

State of Minnesota



East 1/4 Corner of Sec. 29 Township 32 Range 23

On the 13th day of September, 1960, the described corner was evidenced by a granite monument

and to perpetuate the location of said corner, at the exact location thereof, a permanent marker was placed consisting of the same granite monument

AND on the 9th day of March, 2011, said permanent marker was found up 0.3'± and the ties were updated

Updated reference ties are as shown below.

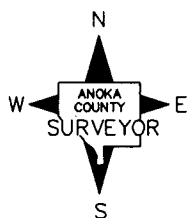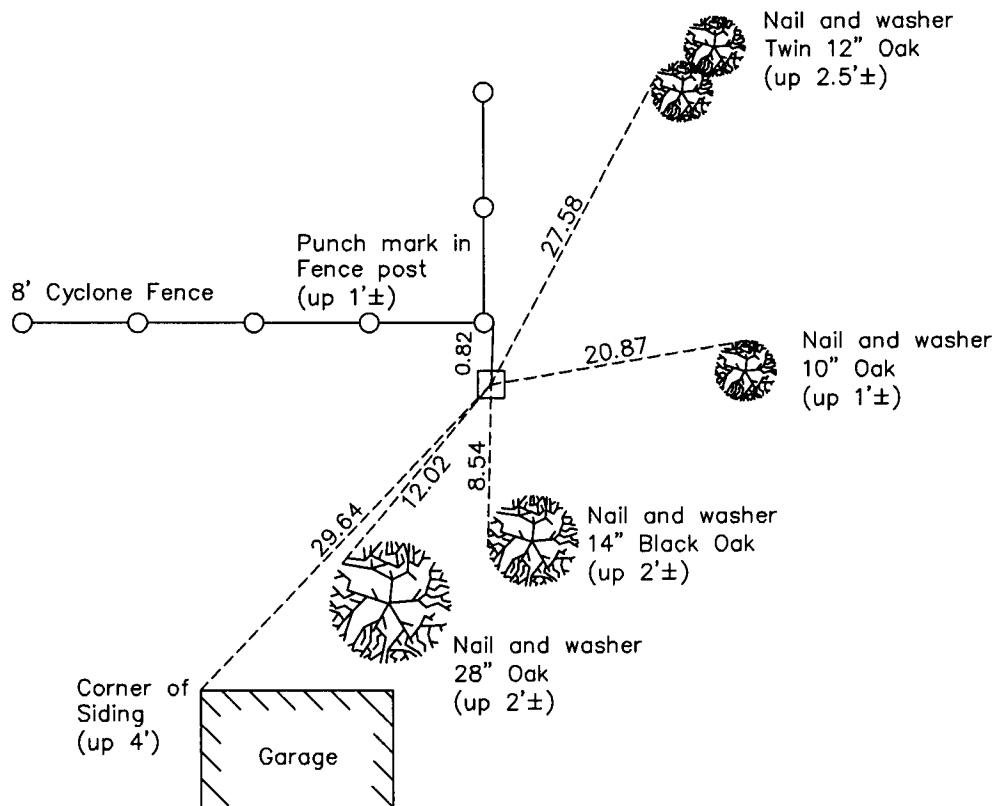

Revision Date

9/28/11

N.A.D. 1983 Coordinates
(1996 Adjustment)

County Project Coordinates	
Northing	172231.1381
Easting	510826.6042
Date	12/12/01

I hereby certify that this United States public land survey monument record is correct and complete to the best of my knowledge and belief.

Larry D. Hoium Date 9/28/11

Larry D. Hoium, Anoka County Surveyor

Minnesota License Number 18165