

# CERTIFICATE OF LOCATION OF GOVERNMENT CORNER

County of Anoka

State of Minnesota



## West 1/4 Corner of Sec. 26 Township 32 Range 23

On the 23rd day of September, 1966, the described corner was evidenced by area resurvey

and to perpetuate the location of said corner, at the exact location thereof, a permanent marker was placed consisting of a cast iron monument

AND on the 22nd day of March, 2011, said permanent marker was found and the ties  
were updated

Updated reference ties are as shown below.

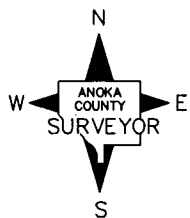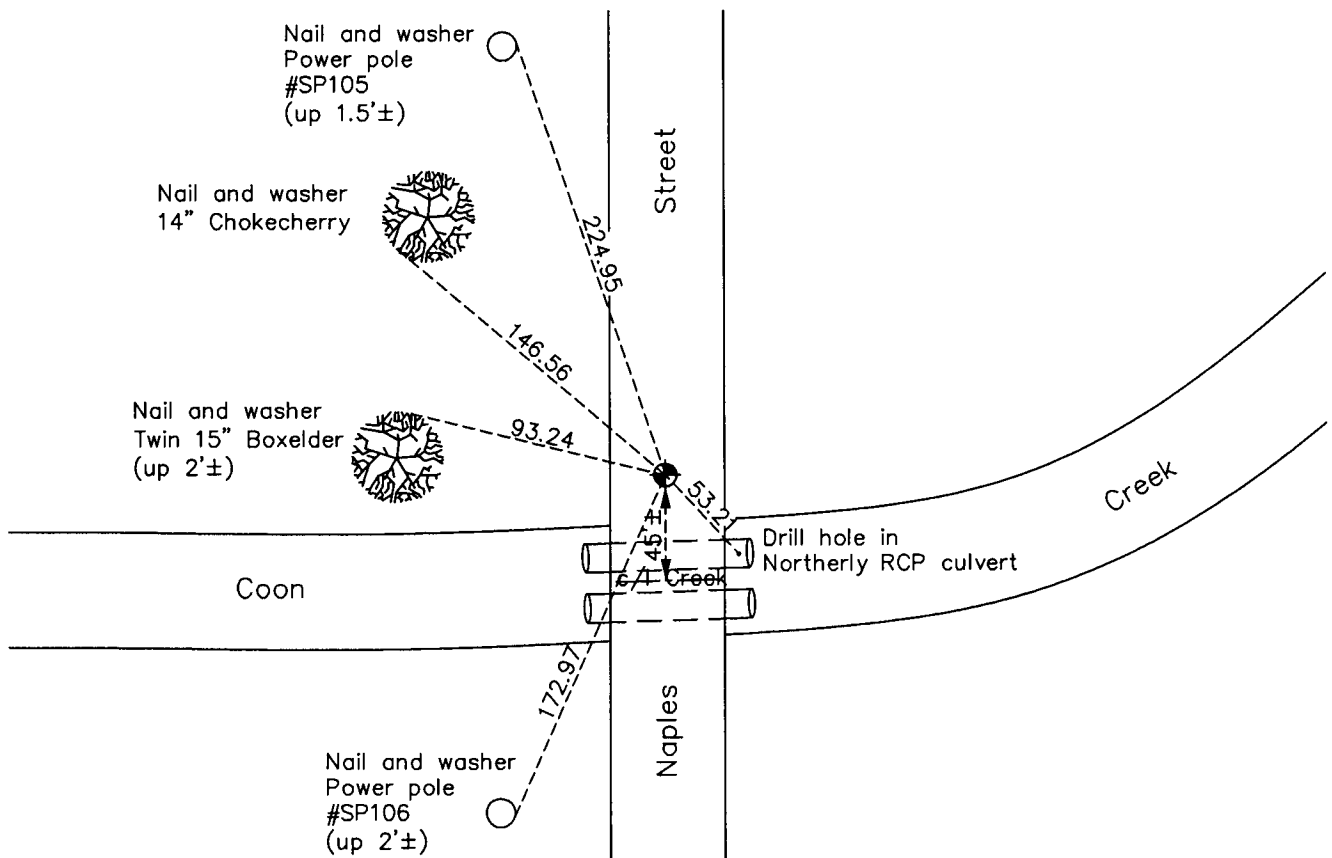

Revision Date

9/29/11

N.A.D. 1983 Coordinates  
(1996 Adjustment)

County Project Coordinates	
Northing	172108.6994
Easting	521463.9910
Date	11/30/01

I hereby certify that this United States public land survey monument record is correct and complete to the best of my knowledge and belief.

*Larry D. Hoium* Date 9/29/11

Larry D. Hoium, Anoka County Surveyor

Minnesota License Number 18165