

CERTIFICATE OF LOCATION OF GOVERNMENT CORNER

County of Anoka


State of Minnesota

CENTER Corner of Sec. 33 Township 32 Range 23

I hereby certify that on the 25 day of JULY, 1960, I found the described corner which was evidenced by IRON PIPE

and I further certify that to perpetuate the location of said corner, I did, at the exact location thereof, place a permanent marker consisting of SAME

which reference or witness monuments are located in the manner following:

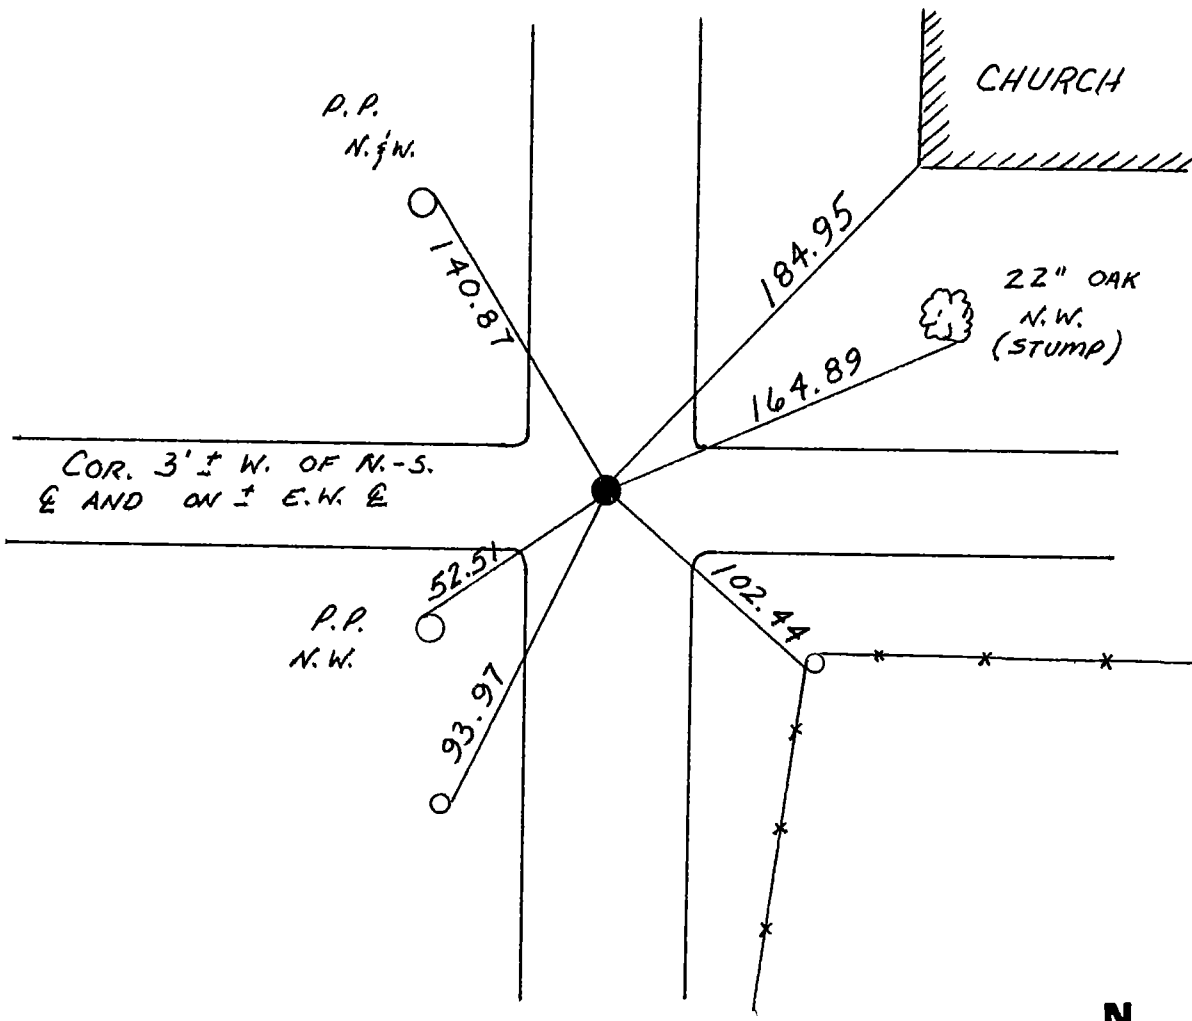

COR. 3' ± W. OF N.-S.
E AND ON ± E.W. E

P.P.
N.W.

Revised date Revised date Revised date

6-29-81		

