

CERTIFICATE OF LOCATION OF GOVERNMENT CORNER

County of Anoka

State of Minnesota



West 1/4 Corner of Sec. 34 Township 32 Range 23

On the 22nd day of March, 1966, the described corner was evidenced by a stone monument

and to perpetuate the location of said corner, at the exact location thereof, a permanent marker was placed consisting of a cast iron monument with a sign and post on the north side

AND on the 25th day of March, 2011, said permanent marker was found and the ties were updated

Updated reference ties are as shown below.

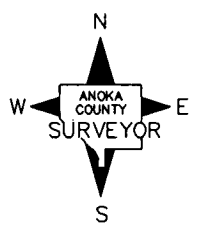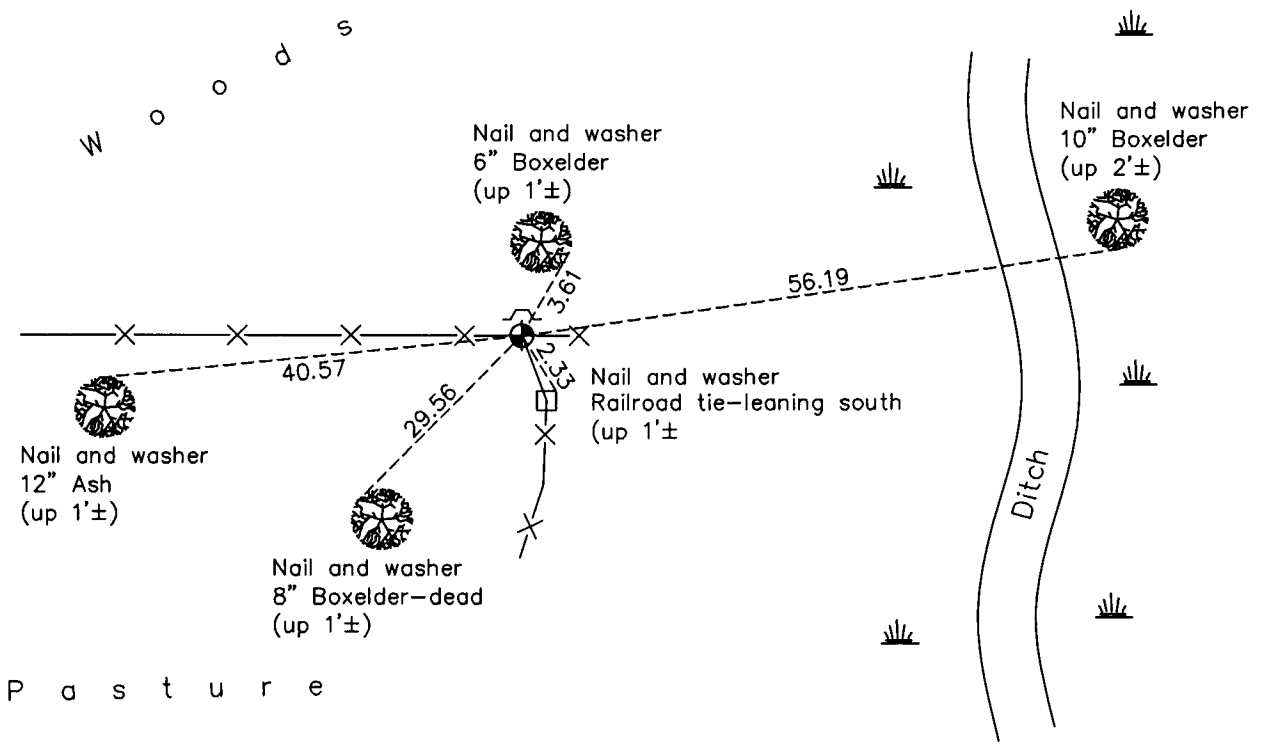

Revision Date
10/12/11

N.A.D. 1983 Coordinates
 (1996 Adjustment)

County Project Coordinates	
Northing	<u>166876.4524</u>
Easting	<u>516145.2201</u>
Date	<u>2/11/02</u>

I hereby certify that this United States public land survey monument record is correct and complete to the best of my knowledge and belief.

Larry D. Hoium Date 10/12/11

Larry D. Hoium, Anoka County Surveyor
 Minnesota License Number 18165