

# CERTIFICATE OF LOCATION OF GOVERNMENT CORNER

County of Anoka

State of Minnesota


Witness Corner of Sec. 28 Township 31 Range 22  
(on west line of section)

On the 27th day of March, 1968, the described corner was evidenced by area resurvey

and to perpetuate the location of said corner, at the exact location thereof, a permanent marker was placed consisting of a cast iron monument

AND on the 19th day of May, 2011, said permanent marker was found broken off and down 0.5'±. Monument was replaced with a new cast iron monument and the ties were updated.

Updated reference ties are as shown below.

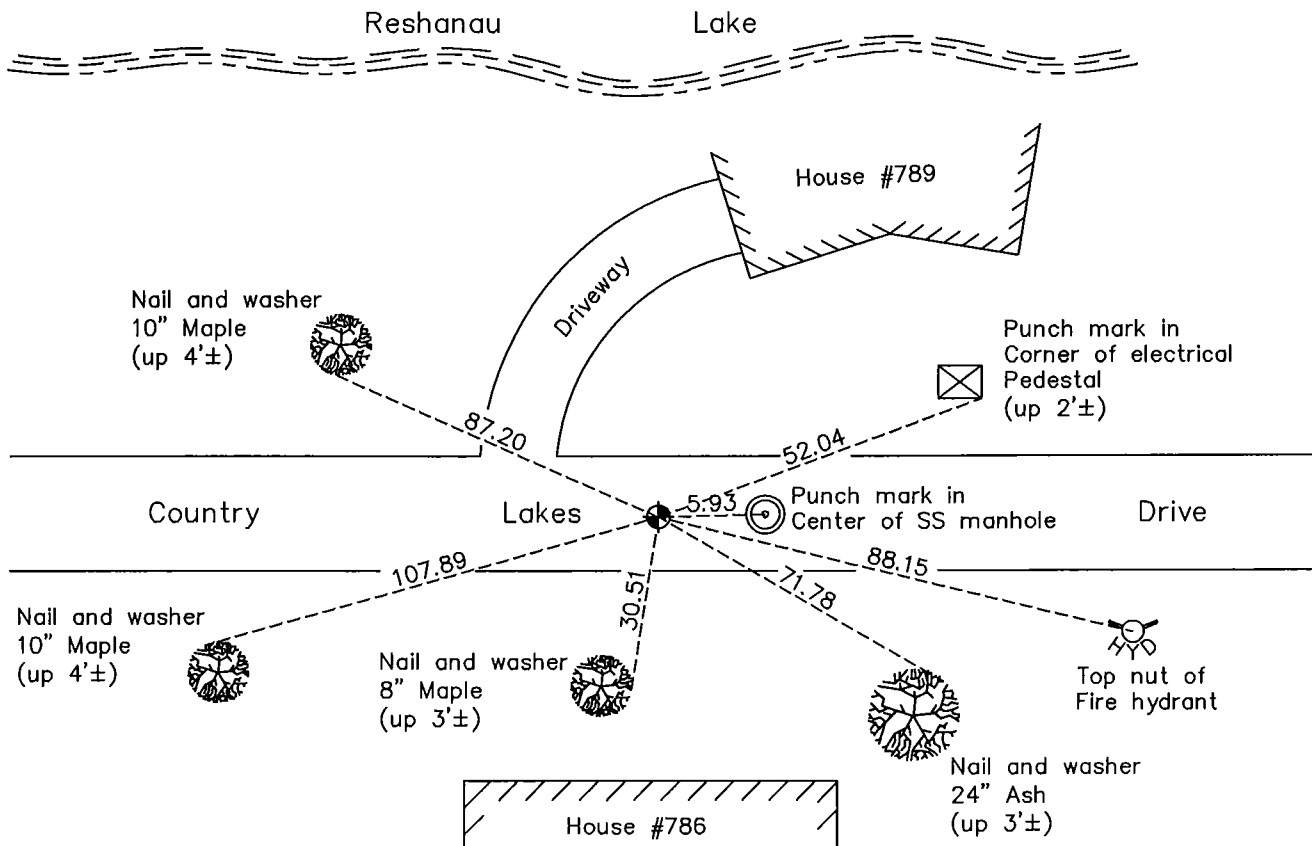

N

W ANOKA COUNTY SURVEYOR E

S

Revision Date

8/18/11

N.A.D. 1983 Coordinates  
(1996 Adjustment)

County Project Coordinates	
Northing	139705.9498
Easting	542515.8676
Date	4/16/96

I hereby certify that this United States public land survey monument record is correct and complete to the best of my knowledge and belief.

*Larry D. Hoium* Date 8/18/11

Larry D. Hoium, Anoka County Surveyor

Minnesota License Number 18165