

CERTIFICATE OF LOCATION OF GOVERNMENT CORNER

County of Anoka

State of Minnesota



Southeast Corner of Sec. 23 Township 33 Range 25

On the 2nd day of October, 1963, the described corner was evidenced by a 6"X6" granite monument

and to perpetuate the location of said corner, at the exact location thereof, a permanent marker was placed consisting of a cast iron monument

AND on the 27th day of May, 2011, said permanent marker was found and the ties were updated. A sign and post was set on the south side.

Updated reference ties are as shown below.

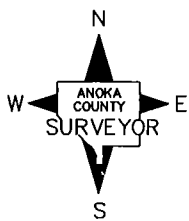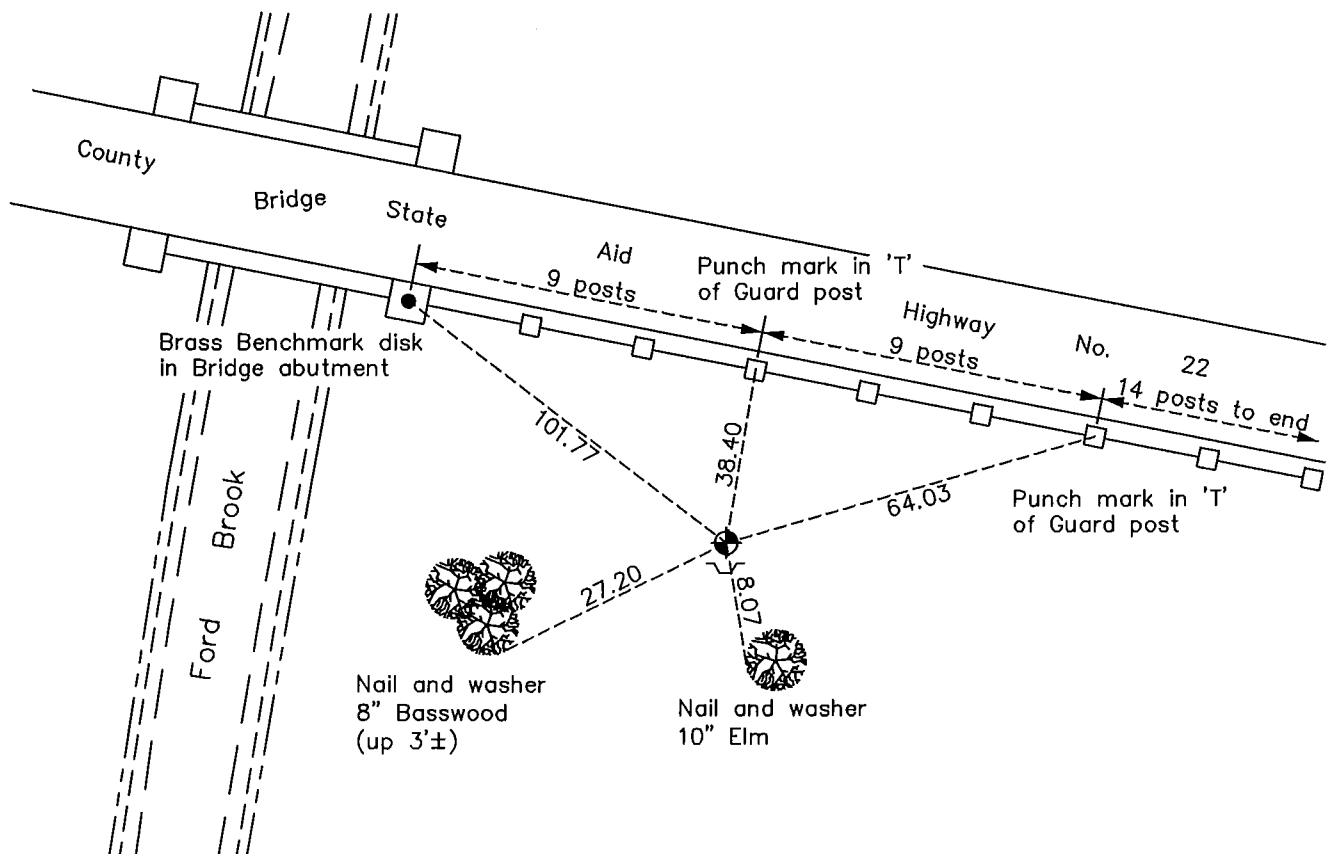

N.A.D. 1983 Coordinates
(1996 Adjustment)

County Project Coordinates	
Northing	206700.3146
Easting	463390.6178
Date	9/26/02

I hereby certify that this United States public land survey monument record is correct and complete to the best of my knowledge and belief.

Larry D. Hoium Date 8/16/11

Larry D. Hoium, Anoka County Surveyor

Minnesota License Number 18165

Revision Date
8/16/11