

CERTIFICATE OF LOCATION OF GOVERNMENT CORNER

County of Anoka

State of Minnesota


Northeast Corner of Sec. 2 Township 31 Range 24

On the ____ day of _____, 1944, the described corner was evidenced by Cartwright ties

and to perpetuate the location of said corner, at the exact location thereof, a permanent marker was placed consisting of a cast iron monument with a sign and post on the north side

AND on the 9th day of February, 2010, said permanent marker was found and the ties
were updated

Updated reference ties are as shown below.

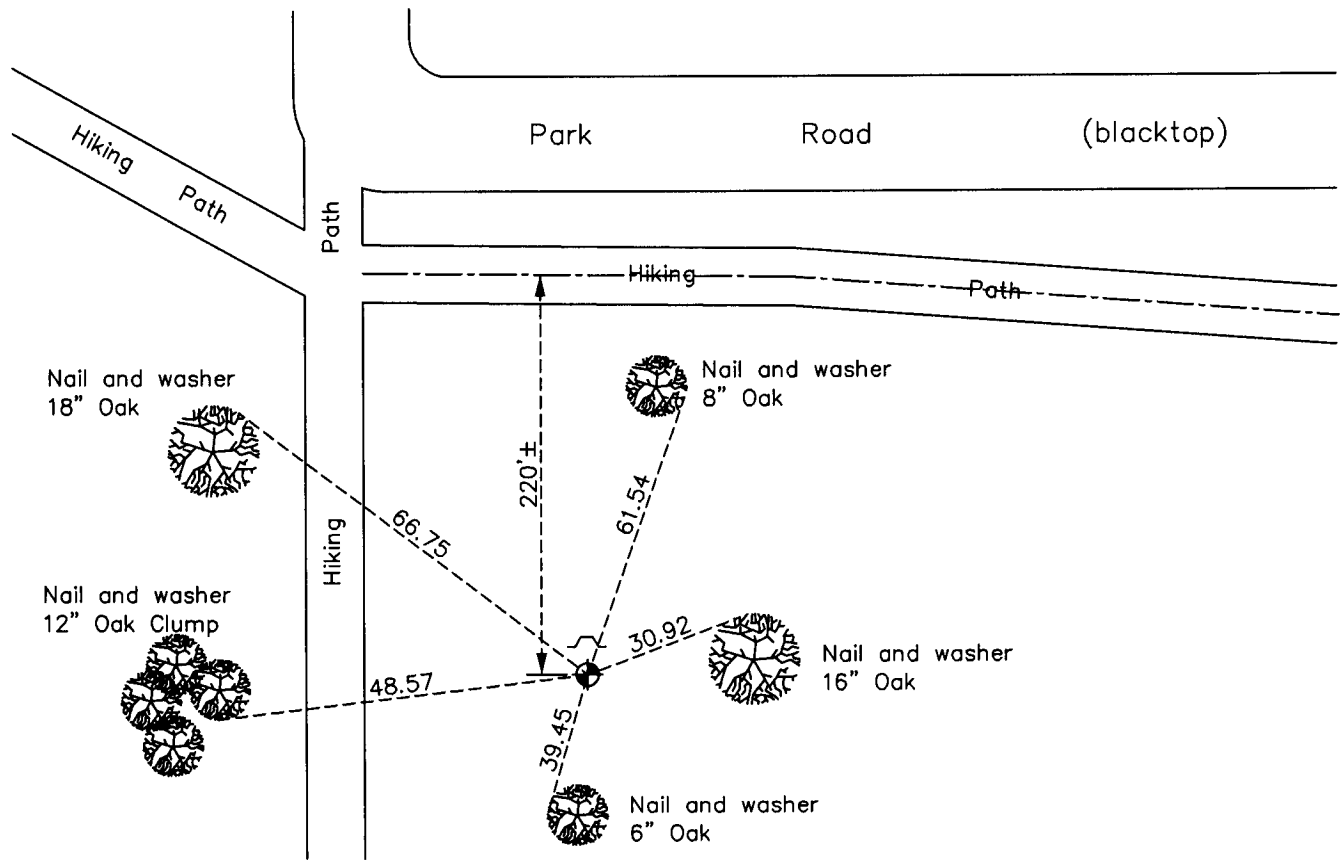

N

 S

Revision Date
4/16/10

N.A.D. 1983 Coordinates
(1996 Adjustment)

County Project Coordinates	
Northing	164359.6199
Easting	494979.0592
Date	11/20/00

I hereby certify that this United States public land survey monument record is correct and complete to the best of my knowledge and belief.

Larry D. Hoium Date 4/16/10

Larry D. Hoium, Anoka County Surveyor
 Minnesota License Number 18165

HISTORY OF GOVERNMENT CORNER

Page No. 3

County of Anoka

State of Minnesota

Northeast Corner of Sec. 2 Township 31 Range 24

CORNER HISTORY:

December 21, 1962 - Found 3/4" pinched iron pipe using Cartwright and Olson ties dated 1944. Updated ties.

November 1, 1966 - Replaced 3/4" pinched iron pipe with a cast iron monument, up 0.1'±, and set sign and post 1'± north. Updated ties.

July 21, 1970 - Found cast iron monument up 0.1' and updated ties.

July 1, 1974 - Found cast iron monument and updated ties.

June 14, 1977 - Found cast iron monument and updated ties.

June 24, 1980 - Found cast iron monument and updated ties.

November 8, 1983 - Found cast iron monument and updated ties.

June 20, 1986 - Found cast iron monument and updated ties.

July 20, 1987 - Set 1/2" iron pipe construction (transit) ties and removed cast iron monument leaving a 1/2" iron pipe in its place prior to construction.

October 28, 1988 - Set cast iron monument after construction using transit ties. Updated ties and set sign and post on the north side.

August 25, 1994 - Found cast iron monument and updated ties.

November 20, 2000 - Found cast iron monument and established NAD 1983 (1996 Adjustment) Anoka County Project Coordinates by Static GPS methods. Updated ties.

February 9, 2010 - Found cast iron monument and updated ties.