

# CERTIFICATE OF LOCATION OF GOVERNMENT CORNER

County of Anoka

State of Minnesota


## West 1/4 Corner of Sec. 5 Township 31 Range 24

On the 17th day of February, 1960, the described corner was evidenced by a concrete monument

and to perpetuate the location of said corner, at the exact location thereof, a permanent marker was placed consisting of a cast iron monument

AND on the 17th day of March, 2010, said permanent marker was found flush and the ties were updated

Updated reference ties are as shown below.

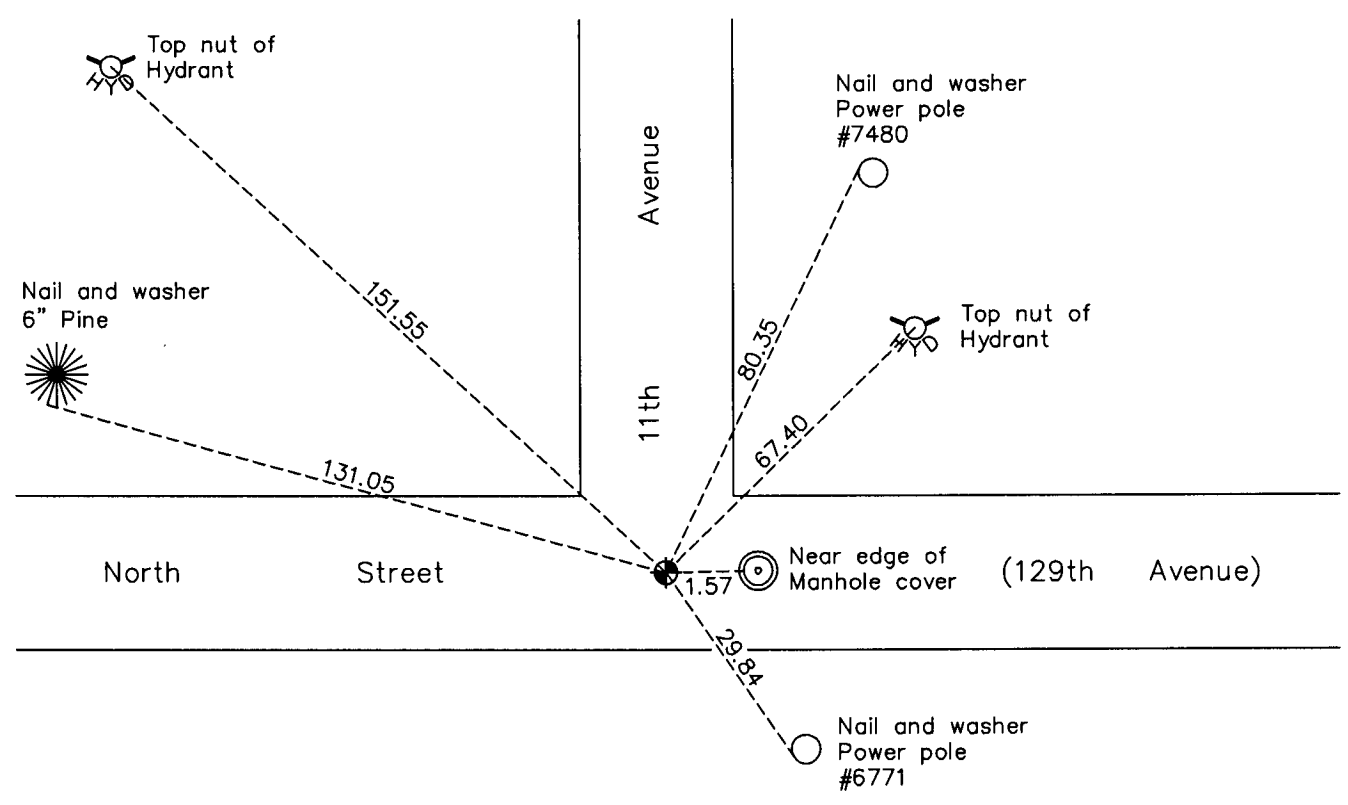

N  
W ANOKA COUNTY SURVEYOR E  
S

Revision Date  
**4/21/10**

N.A.D. 1983 Coordinates  
(1996 Adjustment)

County Project Coordinates	
Northing	161826.1733
Easting	473884.6198
Date	8/07/01

I hereby certify that this United States public land survey monument record is correct and complete to the best of my knowledge and belief.

*Larry D. Hoium* Date 4/21/10  
 Larry D. Hoium, Anoka County Surveyor  
 Minnesota License Number 18165

# HISTORY OF GOVERNMENT CORNER

Page No. 17

County of Anoka

State of Minnesota

West 1/4 Corner of Sec. 5 Township 31 Range 24

## **CORNER HISTORY:**

April 14, 1943 - H.A. Cartwright found concrete monument flush with surface. Established ties to monument.

August 9, 1955 - C.E. Coulter found concrete monument flush with surface on side slope and 16.5' north of centerline Updated ties.

February 17, 1960 - Found concrete monument flush with surface on slope of road and updated ties.

March 25, 1964 - Set construction (transit) ties to concrete monument prior to road construction.

November 18, 1964 - Set P.K. nail after road construction using construction ties. Set P.K. nails 2.00' North and East of corner position.

November 4, 1966 - Replaced P.K. nail with a cast iron monument set flush with surface and updated ties. Monument is 4'± south of centerline.

July 23, 1970 - Found cast iron monument and updated ties.

July 2, 1974 - Found cast iron monument and updated ties. Set P.K.nails 2' North and West of monument.

June 15, 1977 - Found cast iron monument and updated ties.

June 25, 1980 - Found cast iron monument flush with surface and updated ties.

June 16, 1986 - Found cast iron monument and updated ties.

August 21, 1990 - Found cast iron monument and updated ties.

August 18, 1994 - Found cast iron monument and updated ties.

August 7, 2001 - Found cast iron monument and established NAD 1983 (1996 Adjustment) Anoka County Project Coordinates by Static GPS methods. Updated ties.

March 17, 2010 - Found cast iron monument flush with surface and updated ties.