

# CERTIFICATE OF LOCATION OF GOVERNMENT CORNER

County of Anoka

State of Minnesota



## East 1/4 Corner of Sec. 5 Township 31 Range 24

On the 10th day of April, 1943, the described corner was evidenced by a granite monument

and to perpetuate the location of said corner, at the exact location thereof, a permanent marker was placed consisting of a cast iron monument with a sign and post 2.1' north

AND on the 17th day of February, 2010, said permanent marker was found down 0.8' and the ties were updated

Updated reference ties are as shown below.

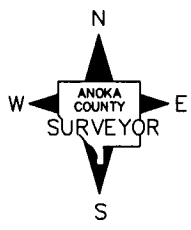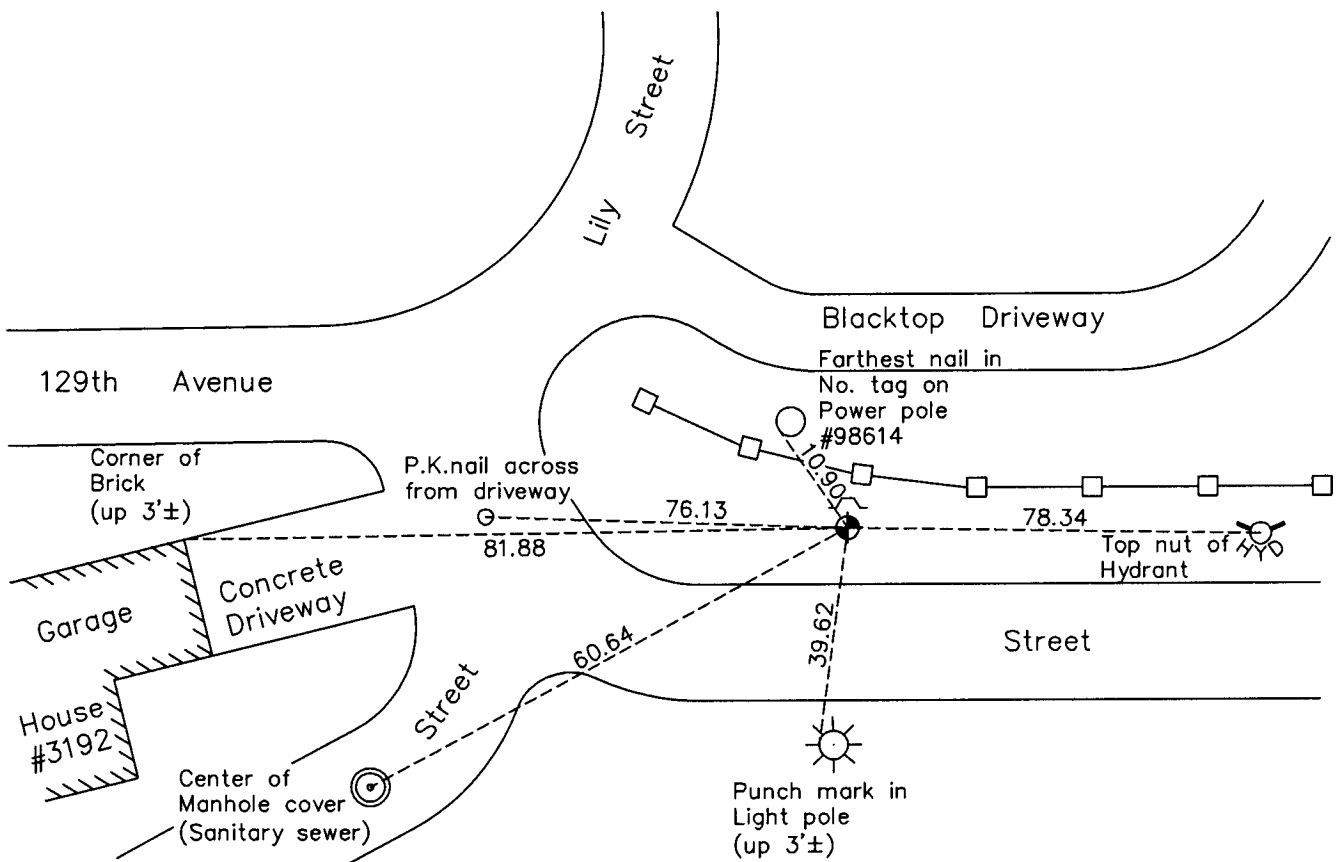

N.A.D. 1983 Coordinates  
(1996 Adjustment)

County Project Coordinates	
Northing	161823.3488
Easting	479135.0871
Date	8/07/01

Revision Date  
4/21/10

I hereby certify that this United States public land survey monument record is correct and complete to the best of my knowledge and belief.

*Larry D. Hoium* Date 4/21/10

Larry D. Hoium, Anoka County Surveyor  
Minnesota License Number 18165

# HISTORY OF GOVERNMENT CORNER

Page No. 18

County of Anoka

State of Minnesota

East 1/4 Corner of Sec. 5 Township 31 Range 24

## **CORNER HISTORY:**

April 10, 1943 - Cartwright found field stone down 1'. Notes call for a granite monument but found field stone only. Stone has been chiseled roughly square. Established ties to stone.

August 9, 1955 - C.E. Coulter found field stone and updated ties.

February 17, 1960 - Found field stone down 8" with a pinched iron pipe on east side and updated ties.

June 8, 1964 - Found field stone and updated ties.

December 2, 1965 - Found field stone and updated ties.

July 14, 1966 - Found field stone and updated ties.

July 22, 1970 - Set broken cast iron monument flush with surface on top of field stone and updated ties. Monument is 4'± north and 8'± east of extended centerlines.

July 2, 1974 - Found cast iron monument and updated ties.

June 16, 1977 - Found cast iron monument and updated ties.

June 20, 1980 - Found cast iron monument and updated ties.

August 16, 1990 - Found cast iron monument and set a sign and post on south side of monument. Updated ties.

August 8, 1994 - Found cast iron monument and updated ties.

September 3, 1997 - Set construction (transit) ties and removed cast iron monument prior to construction.

June 16, 1998 - Set cast iron monument after construction using construction ties and set sign and post on east side of monument.

August 7, 2001 - Found cast iron monument and established NAD 1983 (1996 Adjustment) Anoka County Project Coordinates by Static GPS methods. Updated ties.

February 17, 2010 - Found cast iron monument down 0.8' and updated ties.