

CERTIFICATE OF LOCATION OF GOVERNMENT CORNER

County of Anoka

State of Minnesota



East 1/4 Corner of Sec. 4 Township 31 Range 24

On the 2nd day of August, 1960, the described corner was evidenced by a concrete monument

and to perpetuate the location of said corner, at the exact location thereof, a permanent marker was placed consisting of a 1/2" iron pipe

AND on the 8th day of February, 2010, said permanent marker was found and the ties were updated

Updated reference ties are as shown below.

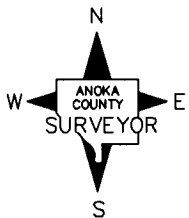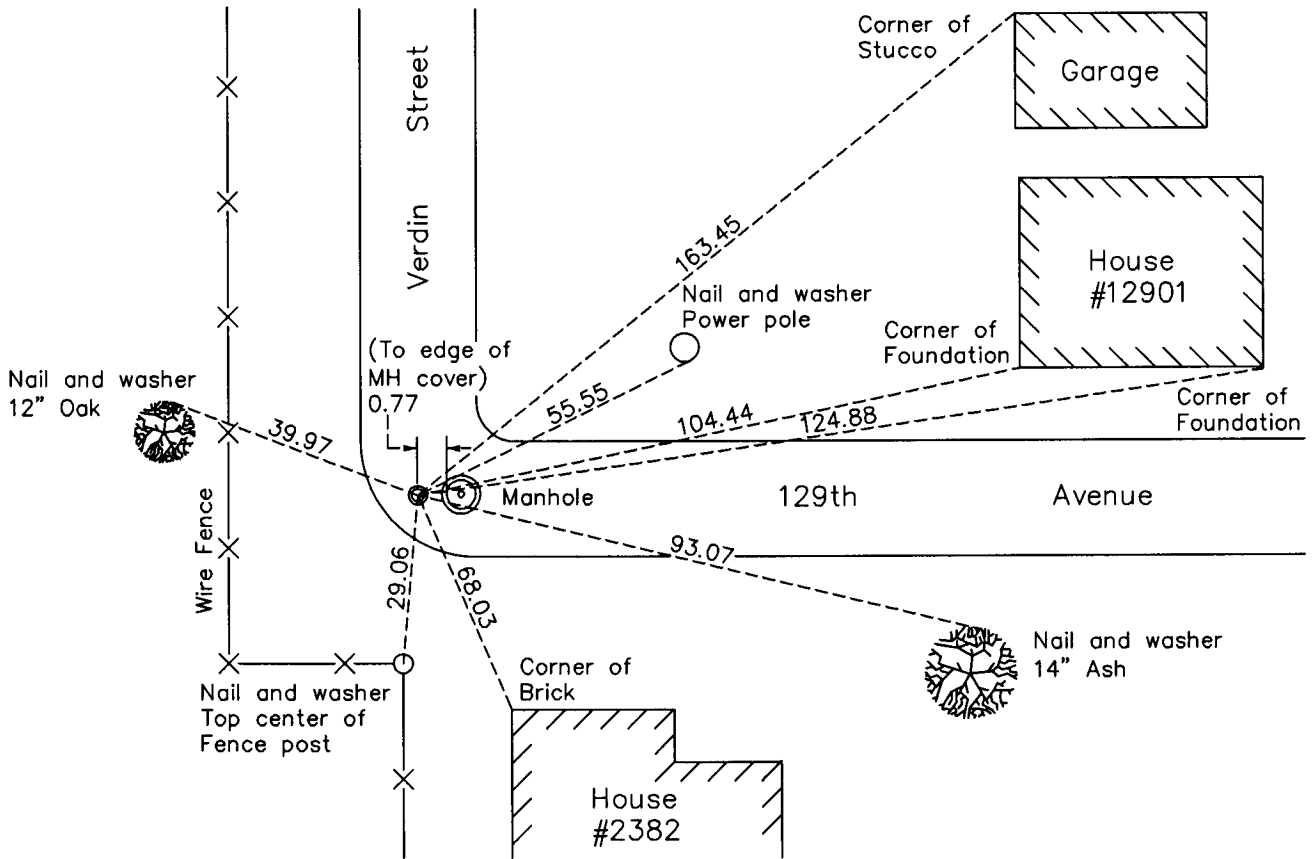

N.A.D. 1983 Coordinates
(1996 Adjustment)

County Project Coordinates	
Northing	161865.6851
Easting	484448.7551
Date	8/10/01

Revision Date
4/21/10

I hereby certify that this United States public land survey monument record is correct and complete to the best of my knowledge and belief.

Larry D. Hoium Date 4/21/10
 Larry D. Hoium, Anoka County Surveyor
 Minnesota License Number 18165

HISTORY OF GOVERNMENT CORNER

Page No. 19

County of Anoka

State of Minnesota

East 1/4 Corner of Sec. 4 Township 31 Range 24

CORNER HISTORY:

December 15, 1944 - Found U.S. Bearing Tree, an 18" rotten stump with old square nail driven into it up 16".
No information given as to what is set in the corner position.

August 2, 1960 - Found concrete monument down 0.2' with an iron pipe on the north side and updated ties.

June 16, 1964 - Found concrete monument and updated ties. Iron pipe could not be found.

July 22, 1966 - Found concrete monument and updated ties.

July 21, 1970 - Found concrete monument and updated ties.

July 3, 1974 - Replaced concrete monument with a cast iron monument set down 0.1' and updated ties.

June 16, 1977 - Found cast iron monument and updated ties.

June 20, 1980 - Found cast iron monument and updated ties.

October 9, 1986 - Updated ties and removed cast iron monument prior to construction. Set 1/2" iron pipe in location of monument.

January 19, 1988 - Found 1/2" iron pipe and updated ties.

August 14, 1990 - Found 1/2" iron pipe and updated ties.

August 17, 1994 - Found 1/2" iron pipe and updated ties.

February 23, 1995 - Found 1/2" iron pipe and updated ties.

August 10, 2001 - Found 1/2" iron pipe and established NAD 1983 (1996 Adjustment) Anoka County Project Coordinates by Static GPS methods.

February 8, 2010 - Found 1/2" iron pipe and updated ties.