

CERTIFICATE OF LOCATION OF GOVERNMENT CORNER

County of Anoka

State of Minnesota



West 1/4 Corner of Sec. 1 Township 31 Range 24

On the 7th day of June, 1943, the described corner was evidenced by a concrete monument

and to perpetuate the location of said corner, at the exact location thereof, a permanent marker was placed consisting of a cast iron monument

AND on the 23rd day of March, 2010, said permanent marker was found down 0.1' and the ties were updated

Updated reference ties are as shown below.

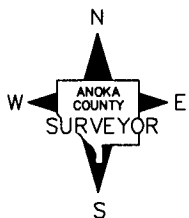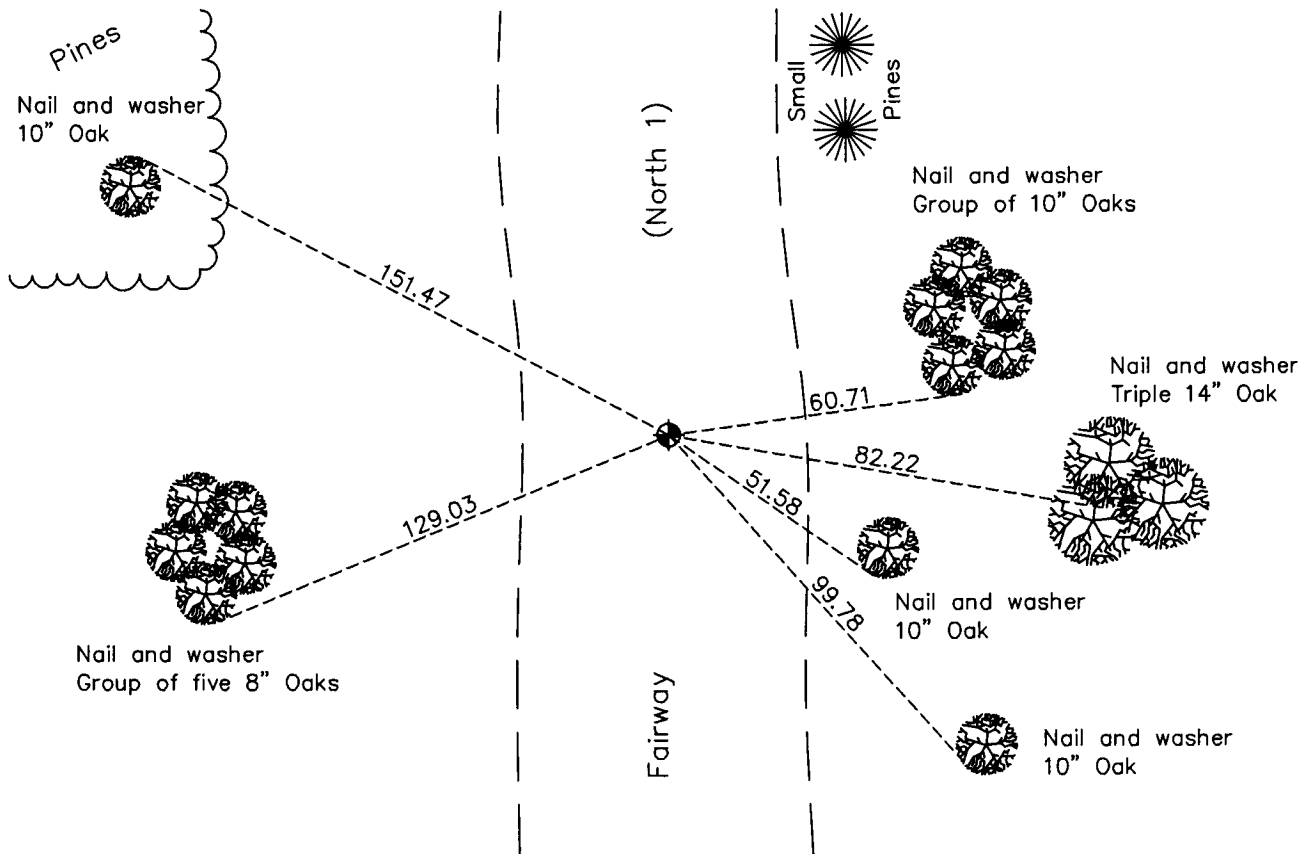

Revision Date
4/22/10

N.A.D. 1983 Coordinates
(1996 Adjustment)

| County Project Coordinates | |
|----------------------------|--------------------|
| Northing | <u>161688.1668</u> |
| Easting | <u>494819.1987</u> |
| Date | <u>10/30/01</u> |

I hereby certify that this United States public land survey monument record is correct and complete to the best of my knowledge and belief.

Larry D. Hoium Date 4/22/10

Larry D. Hoium, Anoka County Surveyor

Minnesota License Number 18165

HISTORY OF GOVERNMENT CORNER

County of Anoka

State of Minnesota

West 1/4 Corner of Sec. 1 Township 31 Range 24

CORNER HISTORY:

June 7, 1943 - H.A. Cartwright found concrete monument flush with surface. Established ties to monument.

August 3, 1960 - Found concrete monument flush with surface and updated ties.

June 8, 1964 - Found concrete monument with iron pipe on North side flush with surface and updated ties.

July 11, 1966 - Found concrete monument with iron pipe on North side flush with surface and updated ties.

October 13, 1966 - Found concrete monument and updated ties. Monument and all ties to be removed for construction of golf course by the City of Coon Rapids.

November 1968 - Set cast iron monument over remains of concrete monument flush with surface of golf course fairway and updated ties.

July 22, 1970 - Found cast iron monument in golf course fairway and updated ties.

July 2, 1974 - Found cast iron monument in golf course fairway and updated ties.

June 16, 1977 - Found cast iron monument in golf course fairway and updated ties.

June 27, 1980 - Found cast iron monument in golf course fairway and updated ties.

July 15, 1983 - Found cast iron monument in golf course fairway and updated ties.

June 17, 1986 - Found cast iron monument in golf course fairway and updated ties.

October 30, 2001 - Found cast iron monument in golf course fairway and established NAD 1983 (1996 Adjustment) Anoka County Project Coordinates by Static GPS methods. Updated ties.

March 23, 2010 - Found cast iron monument down 0.1' in golf course fairway and updated ties.