

CERTIFICATE OF LOCATION OF GOVERNMENT CORNER

County of Anoka


State of Minnesota

W 1/16TH COR. OF NW 1/4 Corner of Sec. 1 Township 31 Range 24

I hereby certify that on the 11 day of October, 1966, I found the described corner which was evidenced by AREA RESURVEY

and I further certify that to perpetuate the location of said corner, I did, at the exact location thereof, place a permanent marker consisting of CAST IRON MONUMENT

which reference or witness monuments are located in the manner following:

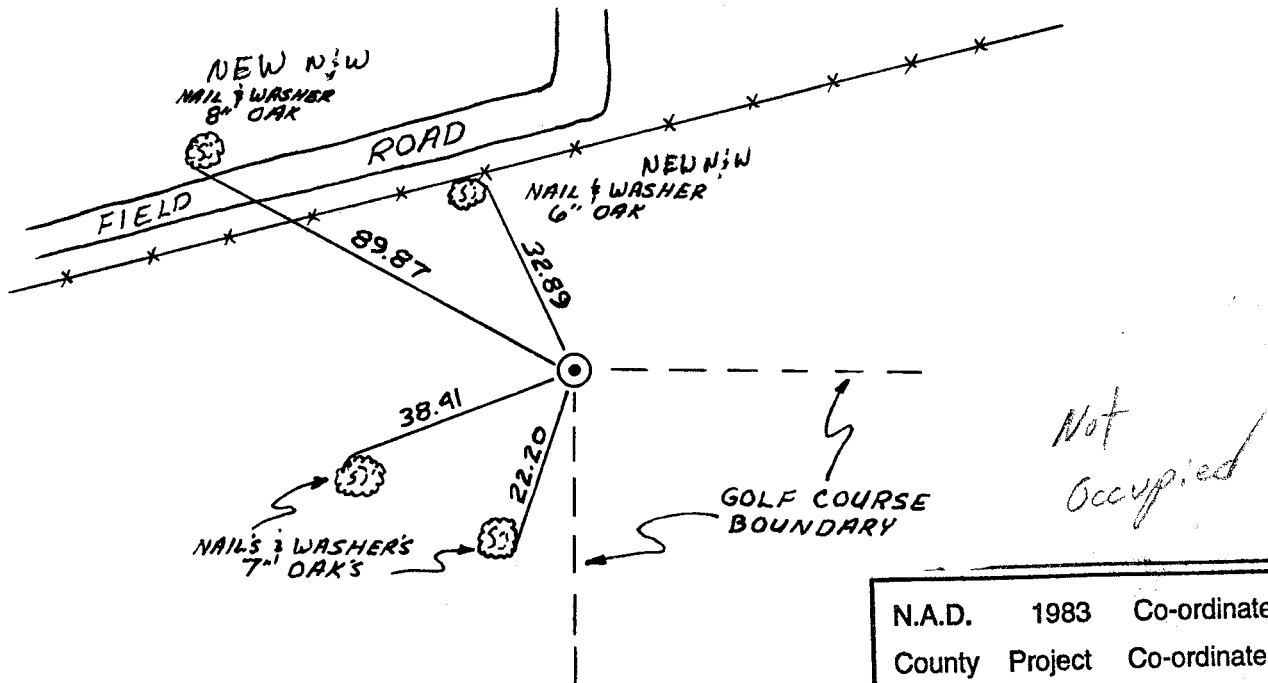

Not Occupied

N.A.D.	1983	Co-ordinates
County	Project	Co-ordinates
Northing		_____
Easting		_____
State Plane Co-ordinates		
Y		_____
X		_____
Date _____		

Revised date	By
10-11-66	M.A. HL. D.P.
7-21-70	D.P. R.B. BO.
7-2-74	R.F. N.D. D.D.
6-16-77	R.S. S.B. J.S.
6-23-80	B.S. P.R. P.H.
7-25-83	P.R. J.B. J.V.
REDRAWN 12-12-83	R. KREUSER
10-11-86	A. Ross

Minnesota State Plane Coordinates
South Zone

Y _____ X _____

_____, _____
County Surveyor Date

Registered Land Surveyor No. _____