

# CERTIFICATE OF LOCATION OF GOVERNMENT CORNER

County of Anoka

State of Minnesota


S 1/16<sup>TH</sup> COR. OF NW 1/4 Corner of Sec. 1 Township 31 Range 24

I hereby certify that on the 8 day of March, 1967, I found the described corner which was evidenced by AREA SURVEY OF BUNKER PARK AREA

and I further certify that to perpetuate the location of said corner, I did, at the exact location thereof, place a permanent marker consisting of CAST IRON MONUMENT

which reference or witness monuments are located in the manner following:

GOLF COURSE

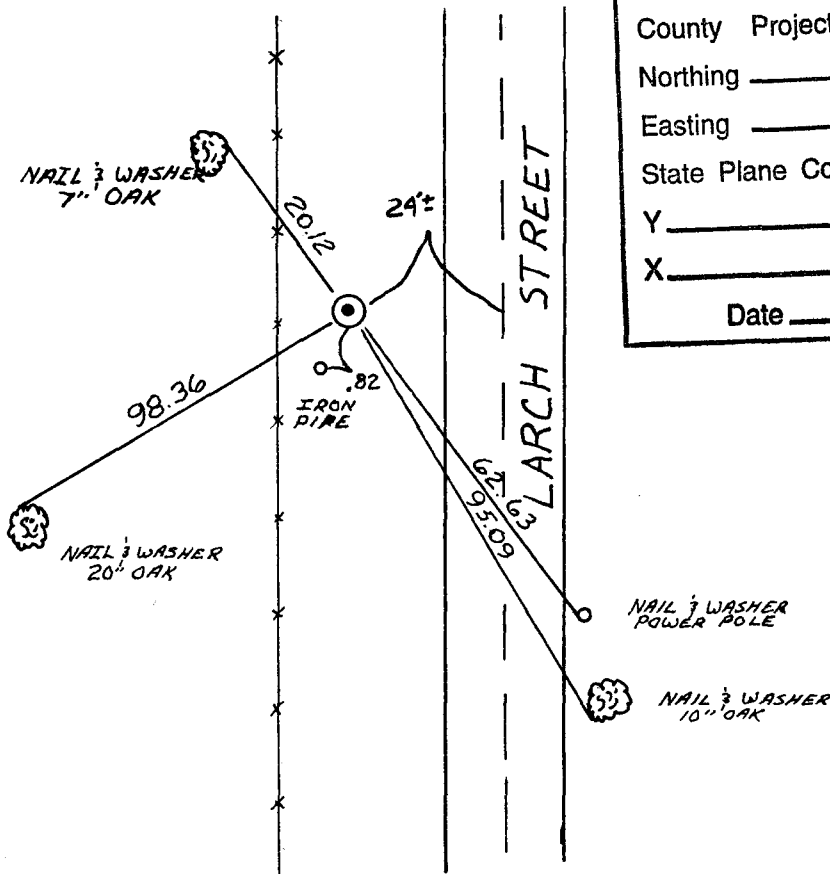

N.A.D.	1983	Co-ordinates
County	Project	Co-ordinates
Northing		_____
Easting		_____
State Plane Co-ordinates		
Y		_____
X		_____
Date _____		

Not occupied

Revised date	By
7-21-70	D.P. R.B. B.O.
7-3-74	R.F. ND. D.D.
6-16-77	R.S. S.B. J.S.
6-23-80	B.S. P.R. P.H.
7-20-83	P.R. J.B. J.V.
REDRAWN 12-12-83	R. KREUSER
6-16-86	D. Pass

**Minnesota State Plane Coordinates**  
**South Zone**

Y \_\_\_\_\_ X \_\_\_\_\_

\_\_\_\_\_  
County Surveyor Date

Registered Land Surveyor No. \_\_\_\_\_